
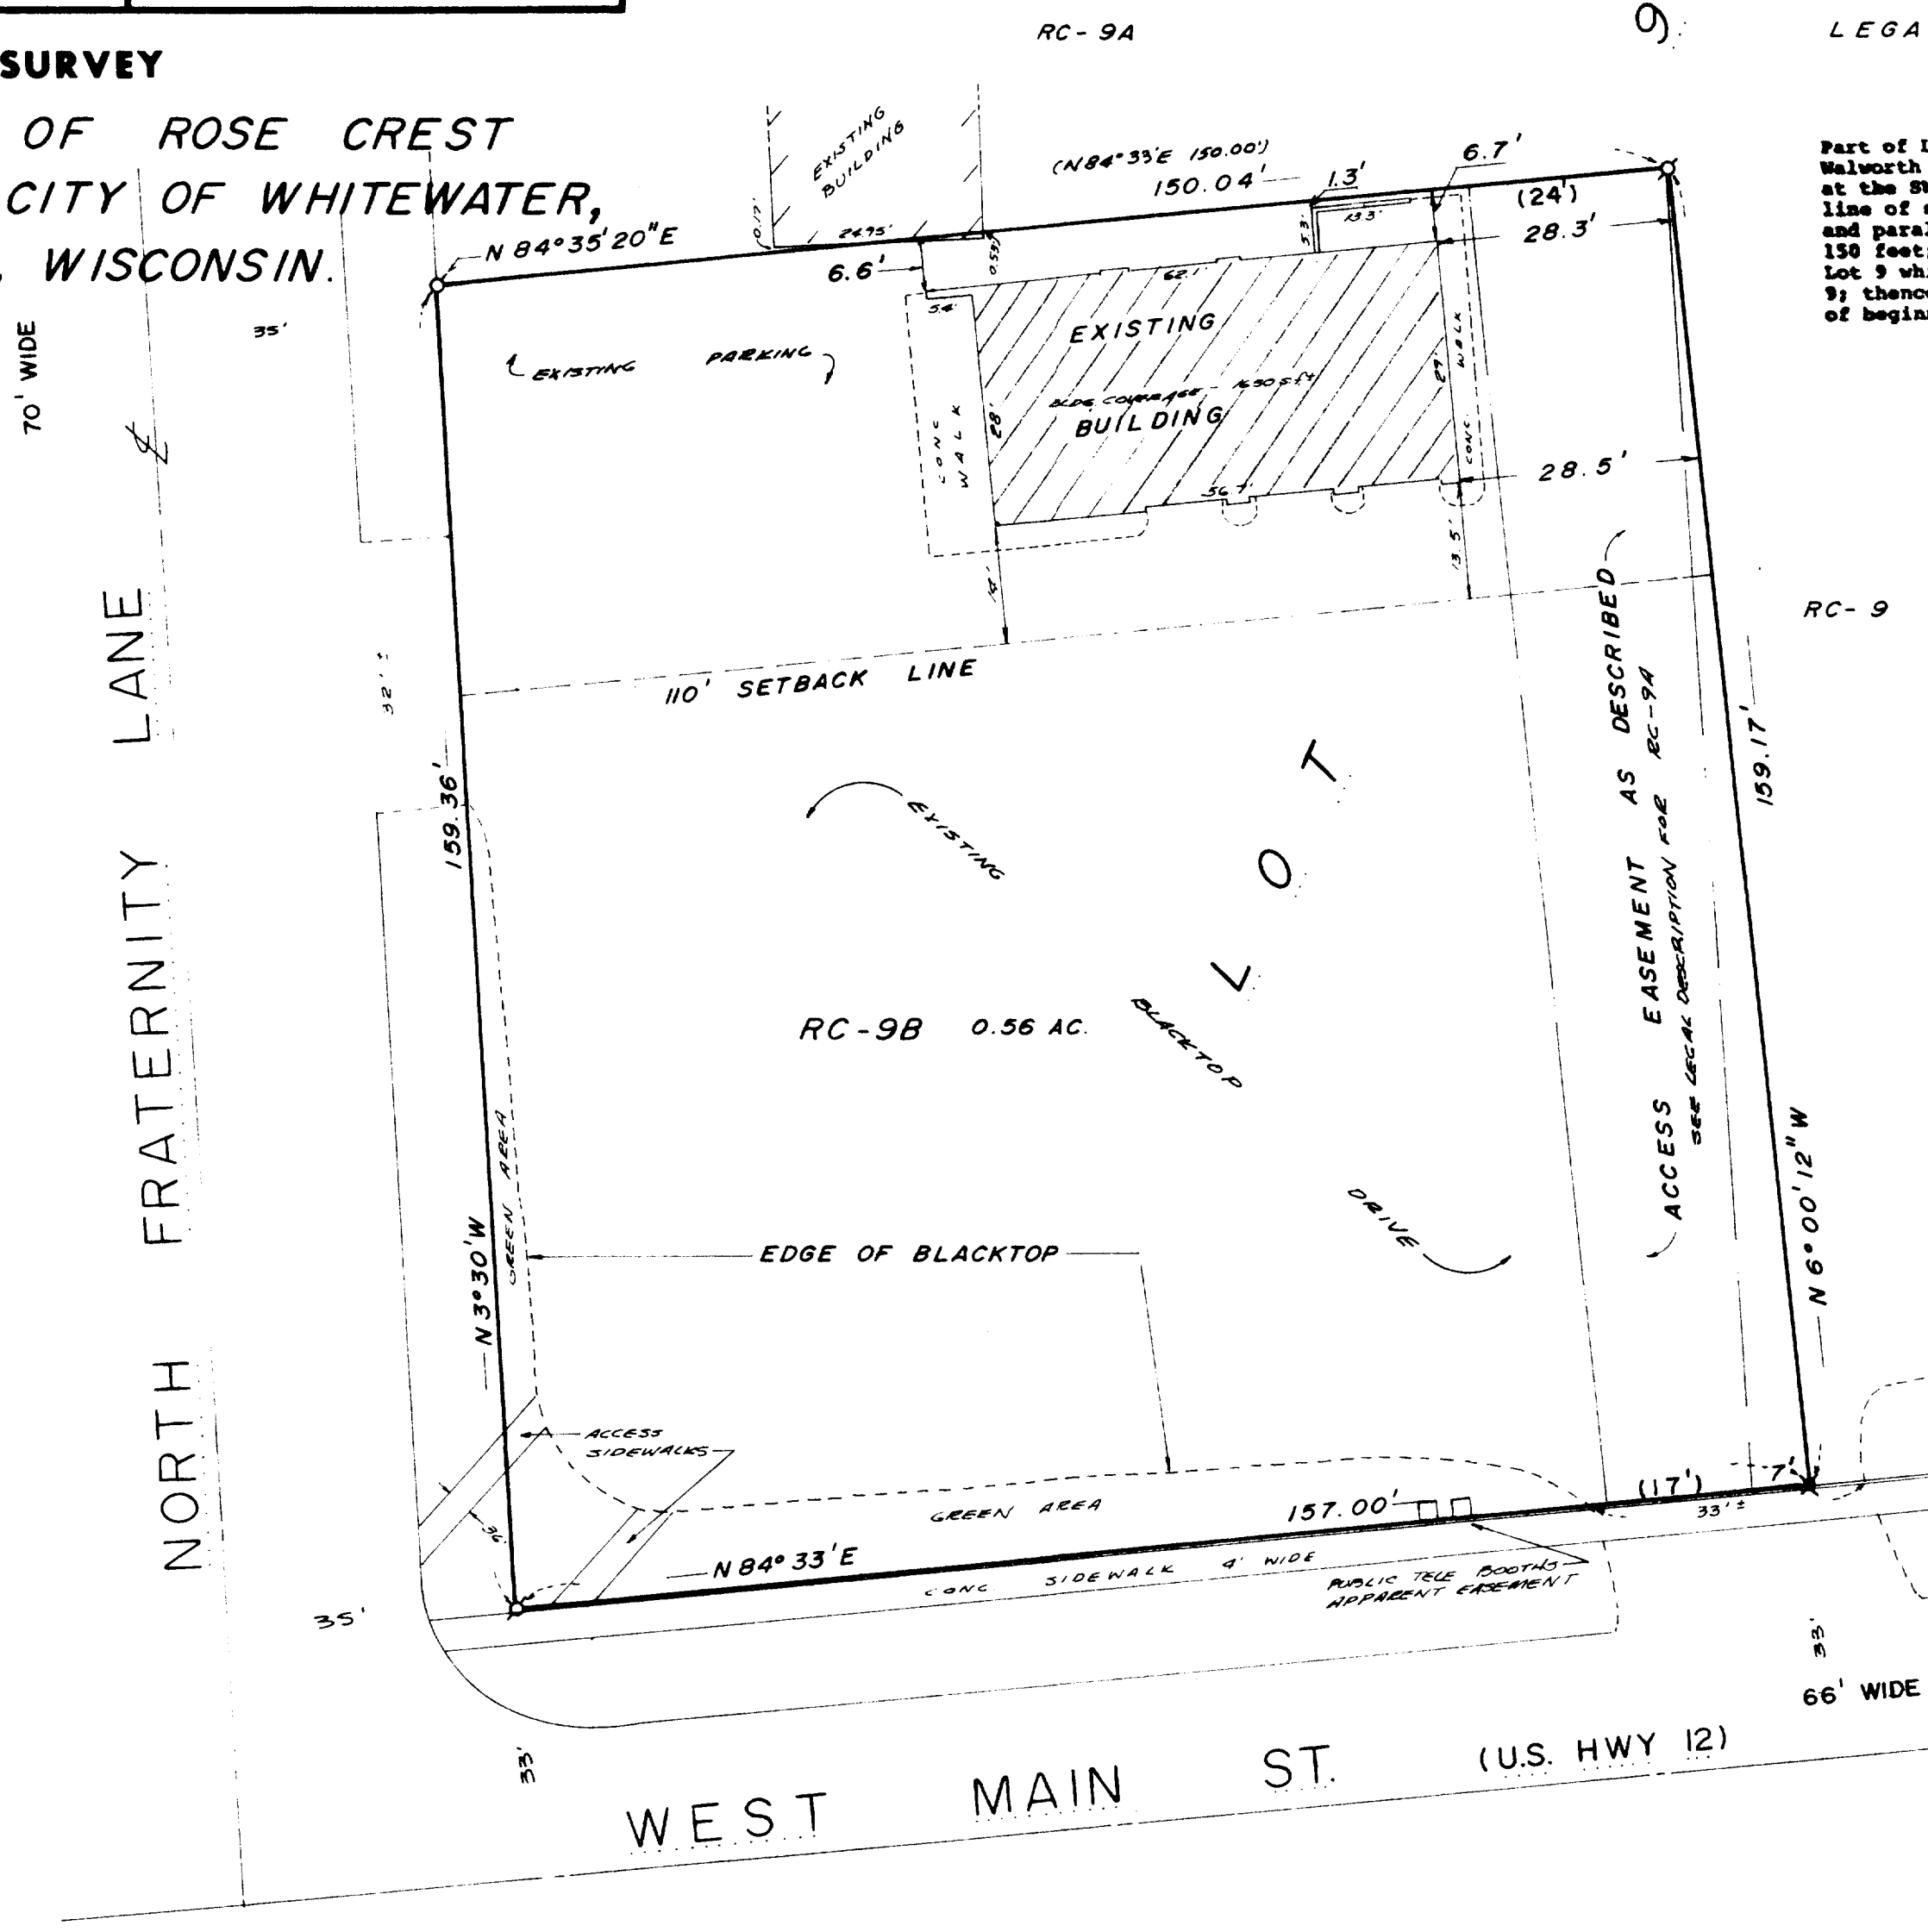


ABERNATHY and ASSOCIATES
Kenneth B. Abernathy Jr.
Wisconsin Registered Land Surveyor S-1594

Rt. 3, Box 273
Elkhorn, Wisconsin 53121
Phone: (414) 723-4260 (office)
(414) 723-4813 (residence)

PLAT OF SURVEY

**PART OF LOT 9 OF ROSE CREST
ADDITION TO THE CITY OF WHITEWATER,
WALWORTH COUNTY, WISCONSIN.**

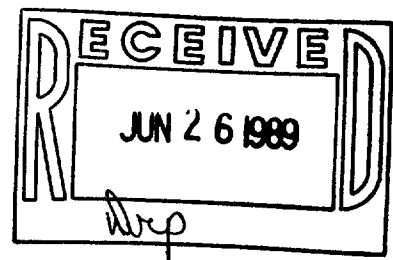



LEGAL DESCRIPTION VOL. 433 P 809

Part of Lot 9 of Rose Crest Addition to the City of Whitewater, Walworth County, Wisconsin, described as follows: Beginning at the SW corner of said Lot 9; thence Northerly along the Westerly line of said Lot 9 a distance of 159.36 feet; thence Easterly and parallel with the North line of said Lot 9 a distance of 150 feet; thence Southerly to a point on the South line of said Lot 9 which point is 157 feet Easterly of the SW corner of Lot 9; thence Westerly on the Southerly line 157 feet to the point of beginning.

SURVEYED FOR - SWATEK ENTERPRISES
1050 CAREY ST.
LAKE GENEVA, WI. 53147

Legend

- FOUND IRON PIPE
- FOUND IRON ROD
- FOUND BRASS CAPPED MONUMENT
- FOUND CONCRETE MONUMENT
- CHISEL CUT IN CONCRETE
- SET IRON ROD, 24" LONG, WEIGHING 1.5 LBS./LINEAL FT., 3/4" DIA.
- SET IRON ROD, 30" LONG, WEIGHING 4.5 LBS./LINEAL FT., 1-11/16" DIA.
- RECORDED AS DIMENSION
- EXISTING FENCE
- SET RAILROAD SPIKE

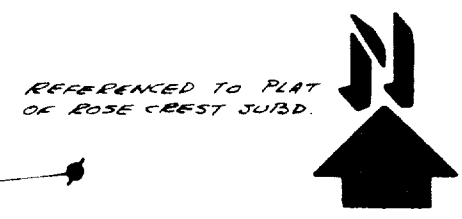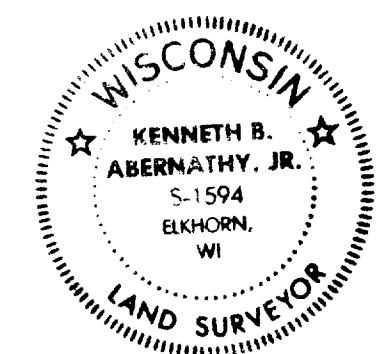

SCALE: 1"= 20' FEET

"I hereby certify that I have surveyed the above described property and that the above map is a true representation thereof and shows the size and location of the property, its exterior boundaries, the location of all visible structures and dimensions of all principal buildings thereon, boundary fences, apparent easements, roadways and visible encroachments, if any."

"This survey is made for the use of the present owners of the property, and also those who purchase, mortgage, or guarantee the title thereto within one year from date hereof."

Kenneth B. Abernathy Jr.
KENNETH B. ABERNATHY, JR.
WISCONSIN REGISTERED LAND SURVEYOR,
S-1594
Date: DEC. 23, 1988 Job No. 88.1101

RC-9B + P. 12, 9