


STARIN

ROAD

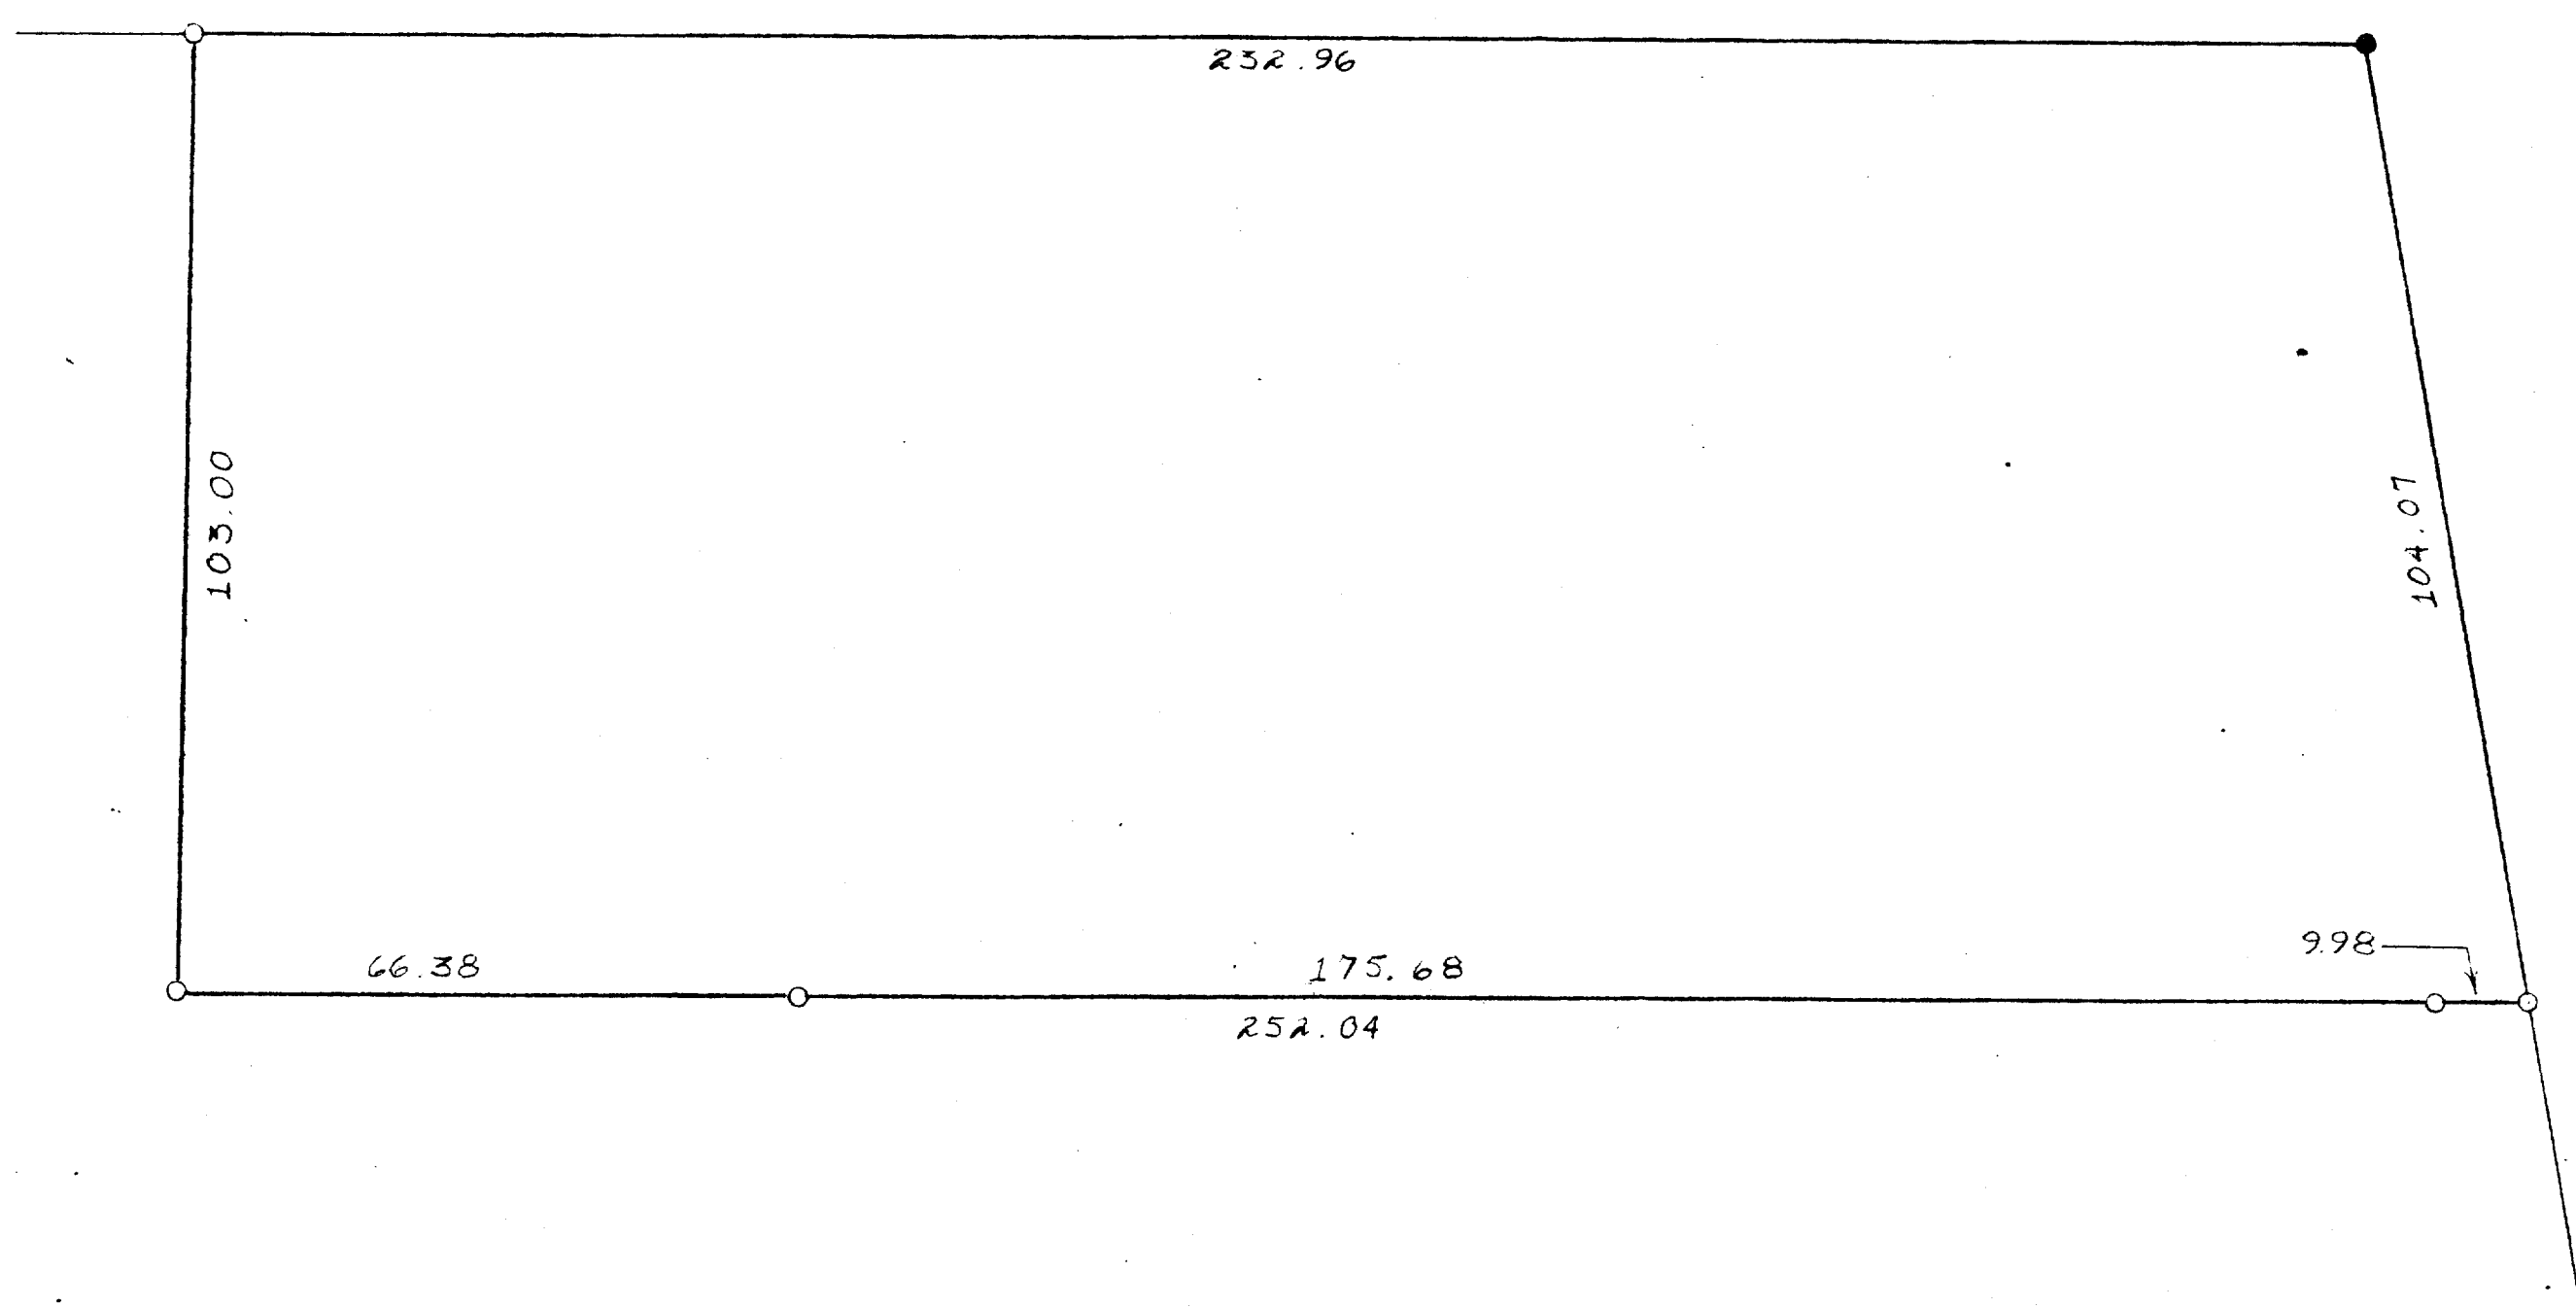

SCALE 1"=20'

● = CONCRETE MONUMENT
○ = IRON PIPE

PLAT OF SURVEY OF A PART OF LOT 13 IN THE FL PRATT ADDITION
TO THE CITY OF WHITEWATER, WALWORTH COUNTY, WISCONSIN
JULY, 1959

George H. Dunham
GEORGE H. DUNHAM, SURVEYOR
DELAVER, WISCONSIN

Pg 67 Co. Sec. Bld Vol 6