


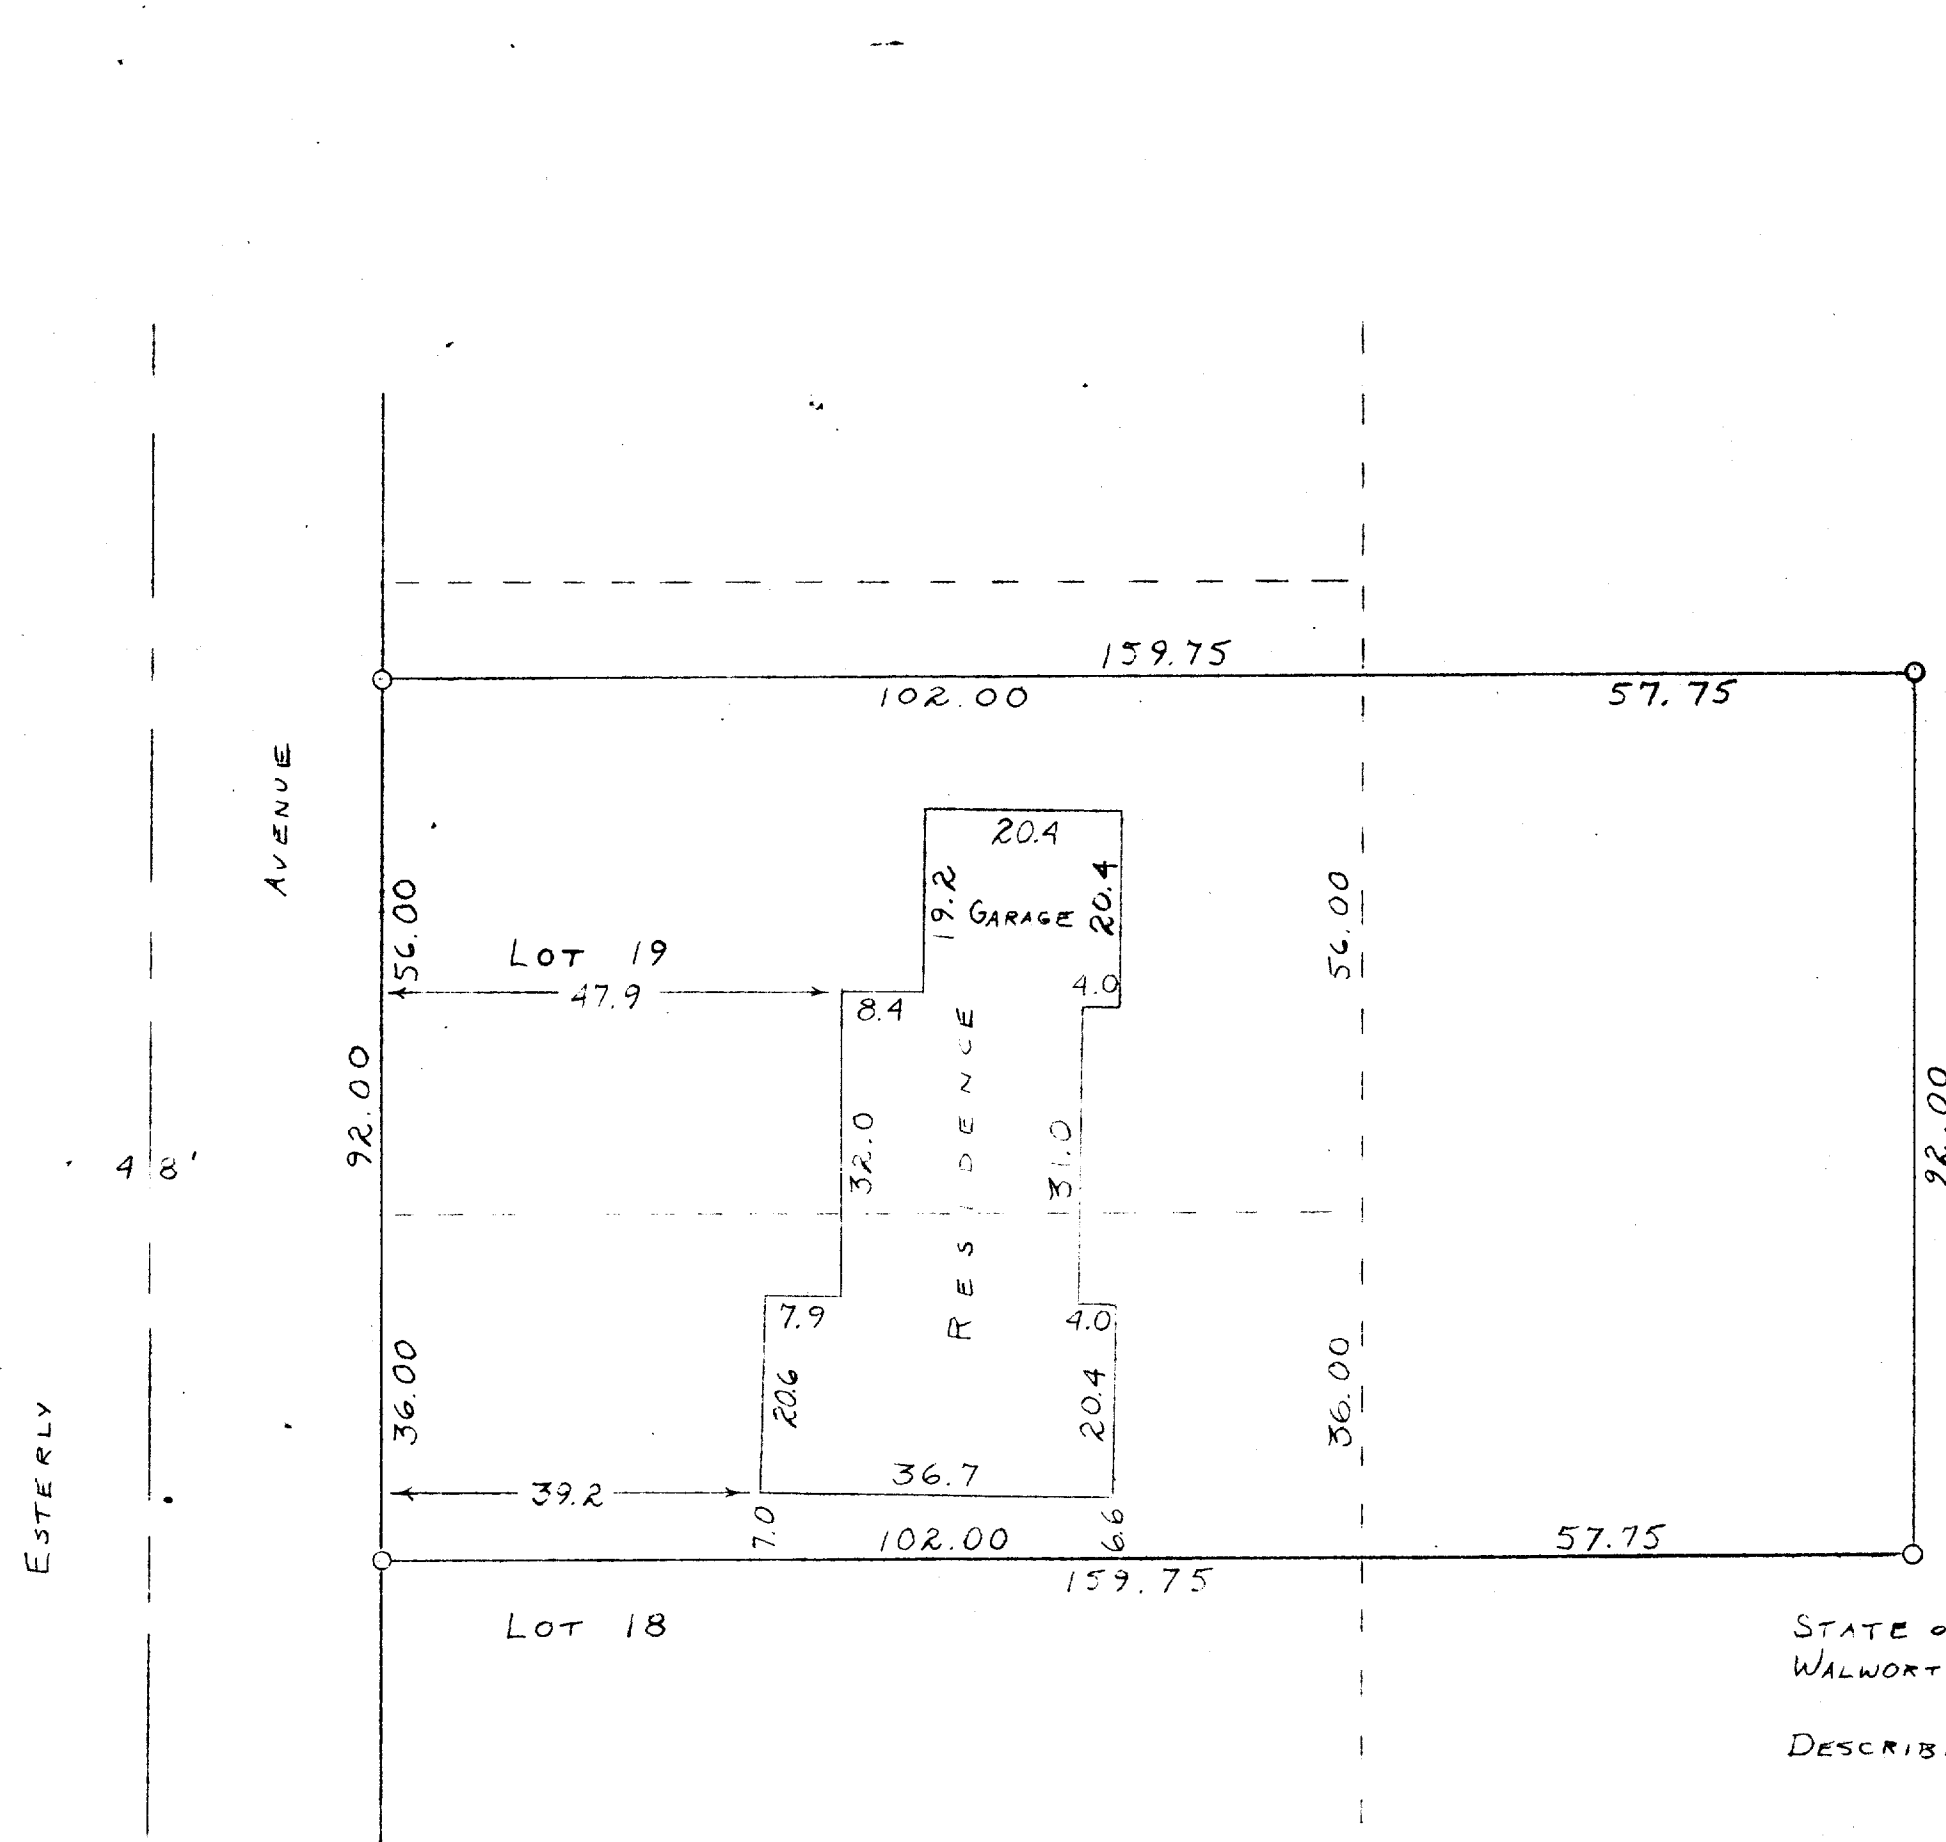

SCALE $\sim 1" = 20'$
O = IRON PIPE

STATE OF WISCONSIN) SS
WALWORTH COUNTY)

I, GEORGE T. DUNHAM DO HEREBY CERTIFY THAT I HAVE SURVEYED THE PROPERTY DESCRIBED AS FOLLOWS:

A PARCEL OF LAND LOCATED IN LOTS 18 AND 19, BLOCK 1 OF FISH AND JOHNSON'S ADDITION TO THE CITY OF WHITEWATER, WALWORTH COUNTY, WISCONSIN DESCRIBED AS FOLLOWS TO-WIT: THE SOUTH 56.00 FEET OF SAID LOT 19 AND THE NORTH 36.00 FEET OF SAID LOT 18. ALSO BEGINNING AT THE NE CORNER OF THE SOUTH 56' OF SAID LOT 19; THENCE EASTERLY ALONG THE EASTERLY EXTENSION OF THE NORTH LINE OF THE SOUTH 56 FEET OF SAID LOT 19, 57.75 FEET; THENCE SOUTH PARALLEL WITH THE EAST LINE OF SAID LOTS 19 AND 18, 92.00 FEET; THENCE WESTERLY 57.75 FEET TO A POINT ON THE EAST LINE OF SAID LOT 18 LOCATED 36 FEET SOUTH OF THE NORTHEAST CORNER OF SAID LOT 18; THENCE NORTHERLY ALONG THE EAST LINE OF SAID LOTS 18 AND 19, 92.00 FEET TO THE PLACE OF BEGINNING.

AND THAT THE PLAT SHOWN ABOVE IS A CORRECT REPRESENTATION OF THE PROPERTY LINES
AND OF THE IMPROVEMENTS LOCATED THEREON.
AUGUST 19, 1959

George T. Dunham
GEORGE T. DUNHAM, SURVEYOR
DELAVER, WISCONSIN