


PLAT OF SURVEY

of

Lot 18 of Mound Park Acres,
located in Section 6, Town 4 North,
Range 15 East, City of Whitewater,
Walworth County, Wisconsin.

Surveyed for: **Wayne Lusk**


450 Buckingham Boulevard
Whitewater, Wisconsin. 53190

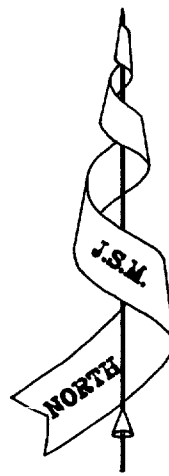


Bearings referenced to the Subdivision
Plat of Mound Park Acres.

Construction Status

Poured Conc. Foundation Complete
Exterior Framing Complete
Roof Complete
Siding Complete
Doors & Windows Partial

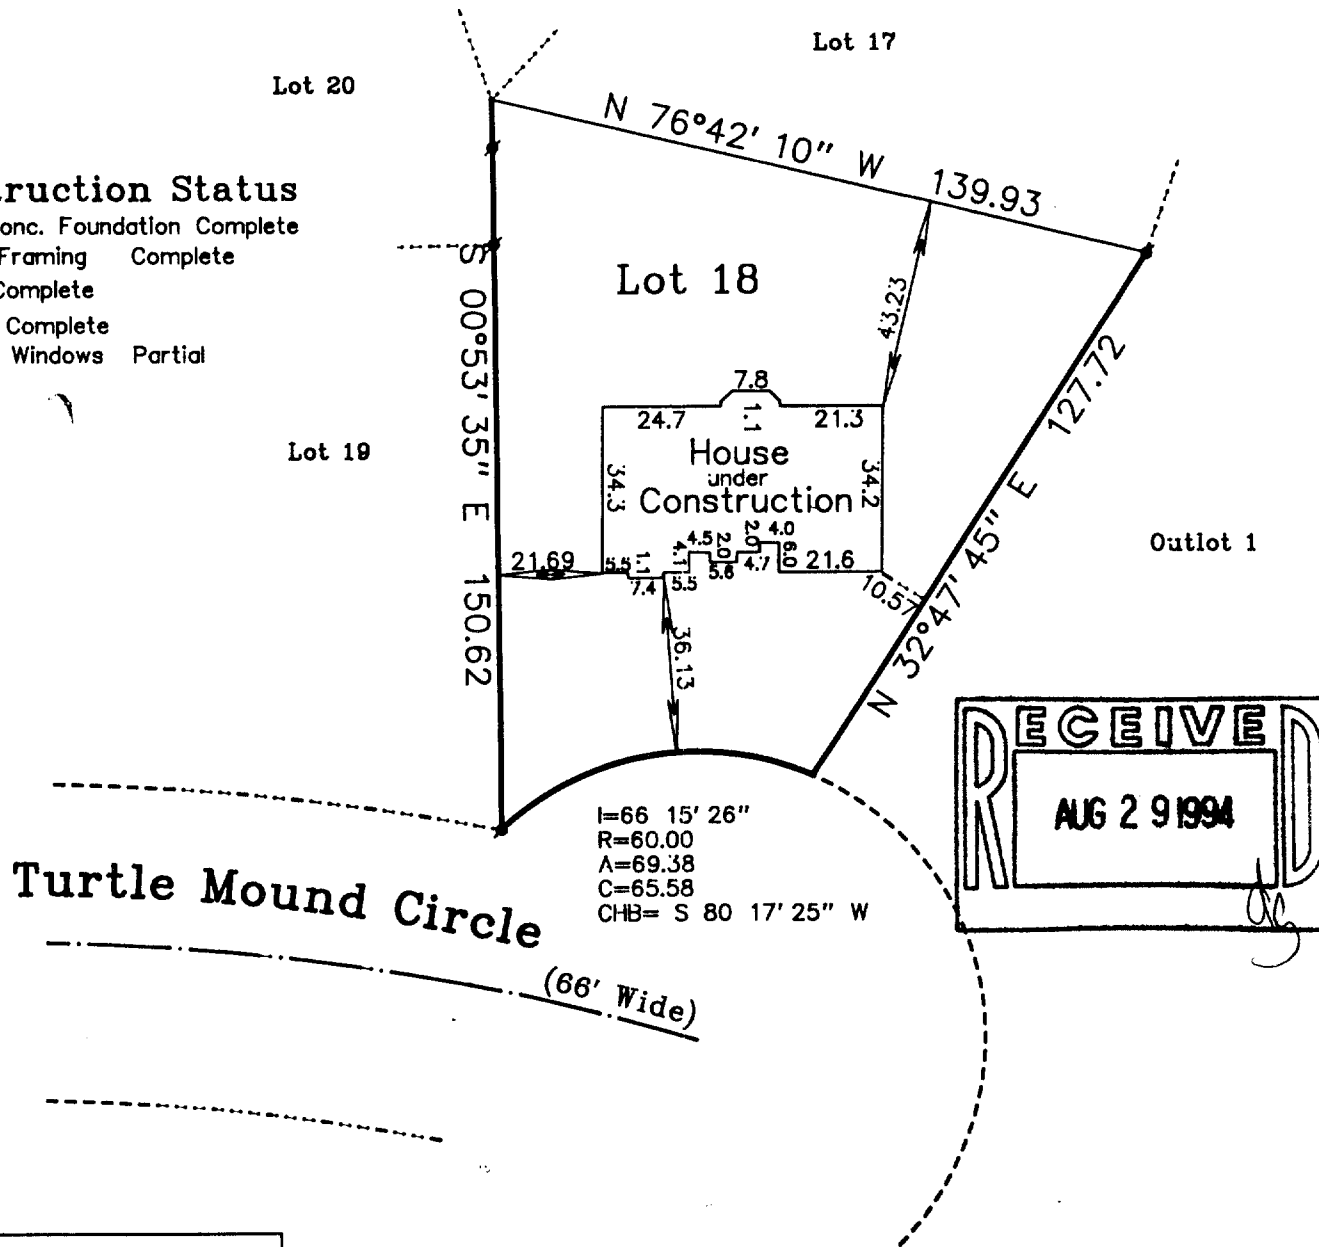

Copy _____ of _____.

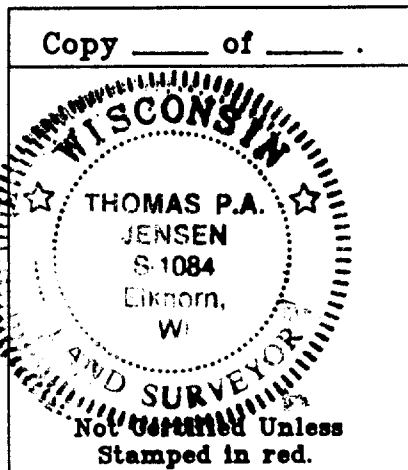

Copyright © 1994 by Jensen Surveying & Mapping S.C.

All rights reserved. No part of this survey plat may be reproduced or transmitted in any form by any means — graphic, electronic, or mechanical, including photocopying, tracing, or information storage and retrieval systems — without permission in writing from Thomas P.A. Jensen, Jensen Surveying & Mapping S.C..

I, Thomas P.A. Jensen, Wisconsin Registered Land Surveyor, do hereby certify that this survey was performed by me, or under my direction in full compliance with the owner's / agent's instructions and Chapter A-E 7 of the Wisconsin Administrative Code "Minimum Standards for Property Surveys"; and that this map is as accurate representation thereof to the best of my knowledge and belief.

Note: This survey plat is not certified unless signed and sealed in red ink.

Thomas P.A. Jensen
Thomas P.A. Jensen R.L.S. 1084

Legend

Found Iron Rod

JENSEN SURVEYING & MAPPING S.C.

45 South Wisconsin Street P.O. Box 322
Elkhorn, Wisconsin. 53121

Telephone & Facsimile (414) 723-3434


Mapping date: 4-28-1994.
Revisions:

Sheet 1 of 1 Sheets

Job Reference number:

1994.023

Scale in Feet
1" = 40'

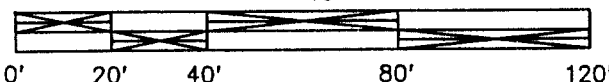

100-18