

HAROLD H. KOLB
RED PROFESSIONAL LAND SURVEYOR
LAKE GENEVA, WISCONSIN

PLAT OF SURVEY OF

A parcel of land located in the NW 1/4 of Section 5, T 4 N, R 15 E, City of Whitewater, Walworth County, Wisconsin and described as follows; to-wit: Commencing at the intersection of the centerlines of Pratt and Main Streets; thence N 30°45' W 1011.46 feet; thence S 84°35' W 183.01 feet to the place of beginning; thence continue S 84°35' W 84.00 feet; thence N 30°45' W 150.00 feet; thence N 84°35' E 84.00 feet; thence S 30°45' E 150.00 feet to the place of beginning.


State of Wisconsin)
County of Walworth) SS

I certify that I have surveyed the above described property and that the plat hereon is an accurate survey and a true representation thereof and correctly shows the exterior boundary lines and all improvements on said property.

Harold A. Koff

Harold H. Kolb, Wisconsin Surveyor, S-187
DATE: January 18, 1964

REVISED: November 17, 1964

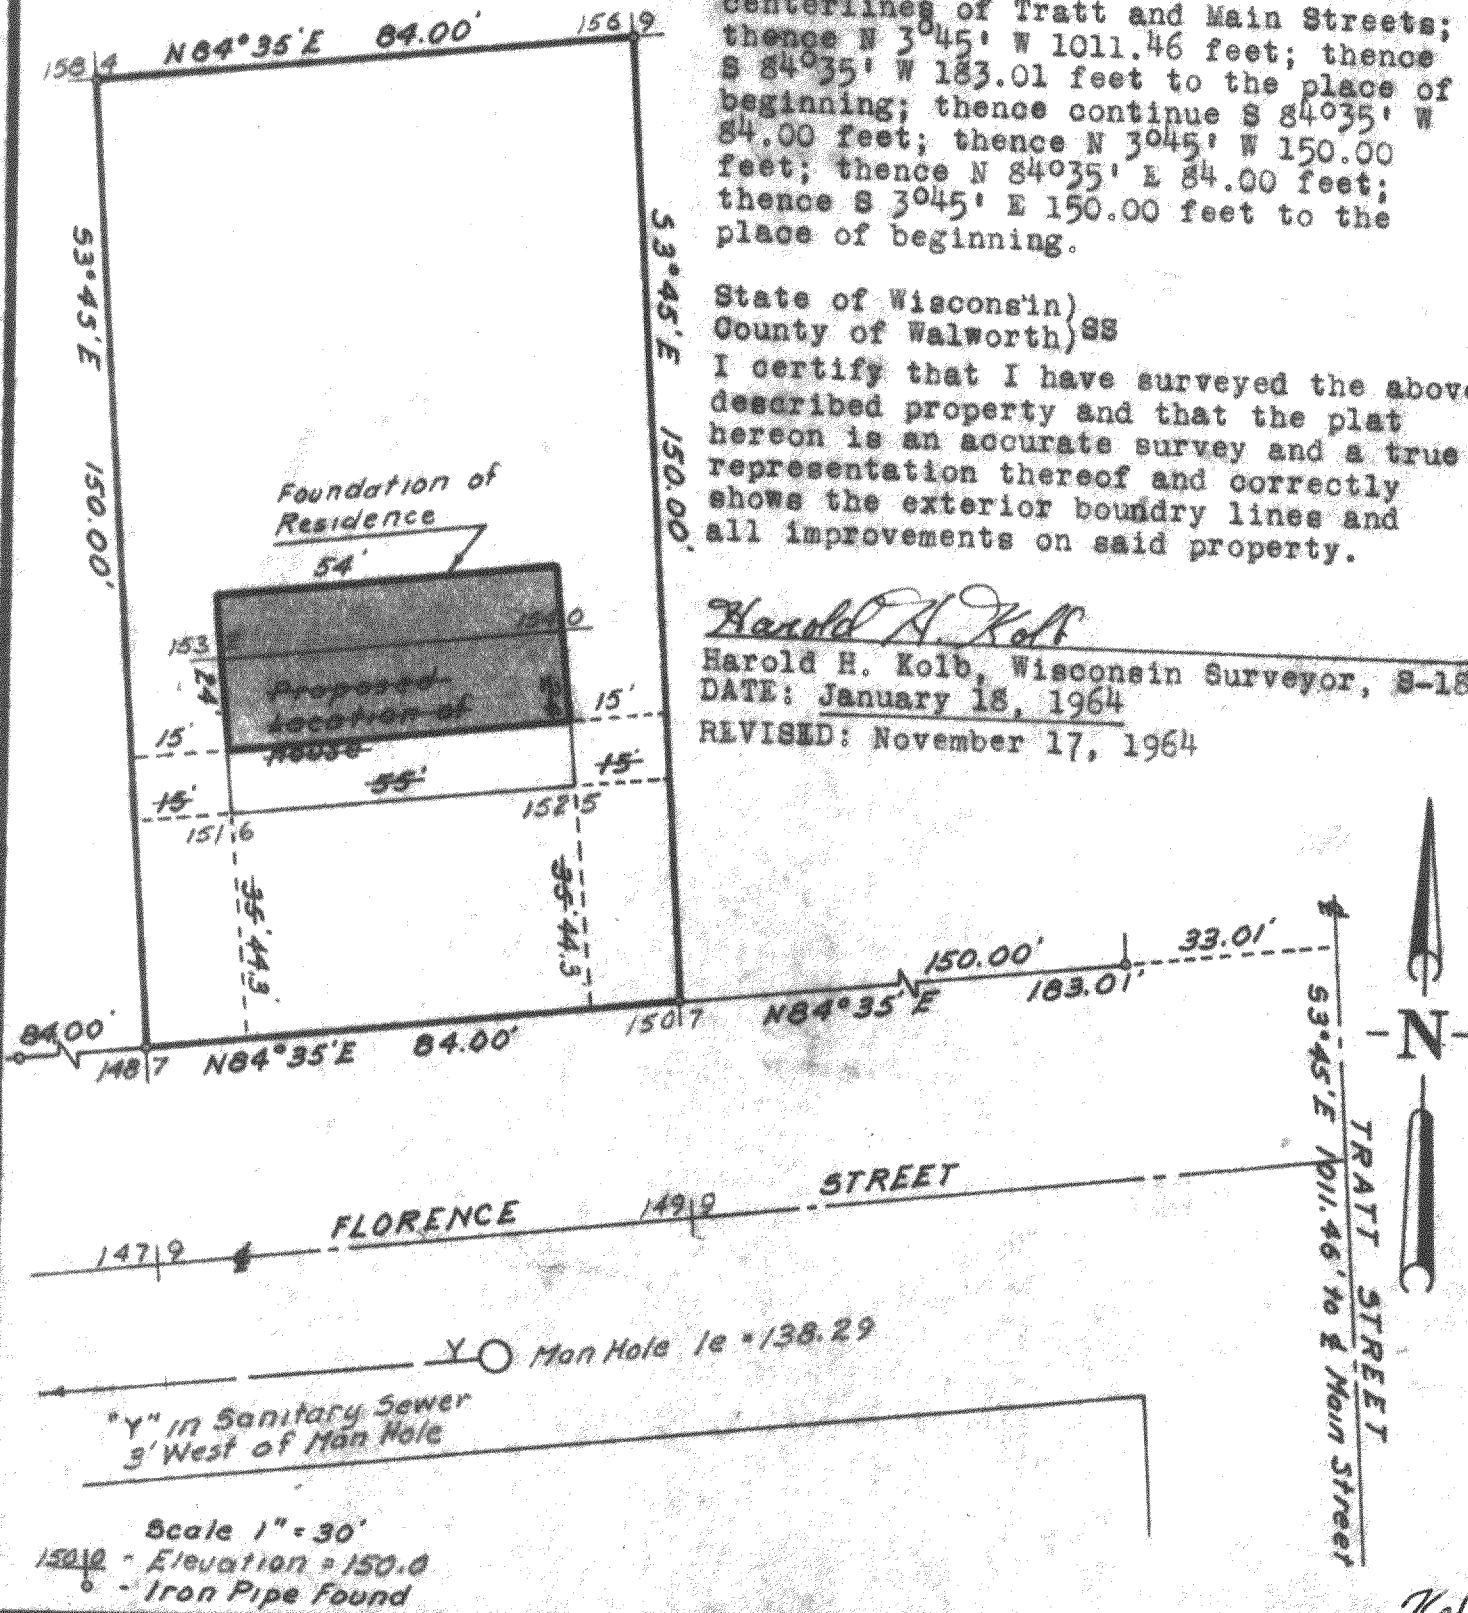

Kel

UP-158I