


Plat of Survey

of  
Lot 7 of Walton Crest,  
a subdivision located in the Northwest 1/4 of Section 8,  
Town 4 North, Range 15 East, City of Whitewater,  
Walworth County, Wisconsin.

Surveyed for: Wells Fargo Bank  
735 West Wisconsin Avenue  
Milwaukee, Wisconsin. 53233

Survey Date: May 23, 2005.  
Revisions:

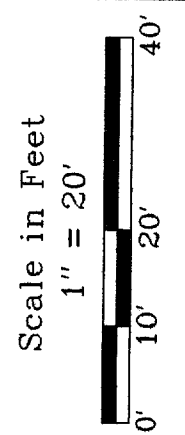


Jensen & Olson Land Surveying, LLC  
45 South Wisconsin Street  
Elkhorn, Wisconsin. 53121  
Telephone (262) 723-3434  
Facsimile (262) 723-8044


Legend  
Found Iron Pipe  
Recorded Information  
Utility Pedestal  
Concrete Surface  
Asphalt Surface

Sheet 1 of 1 Sheets  
Job Reference Number  
2005.078

2005.078

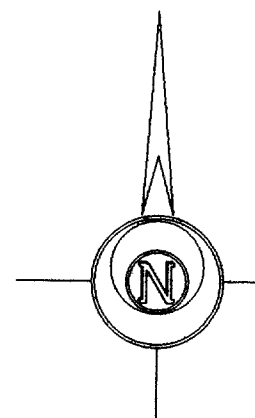

Bearings reference to the  
plat of Walton Crest.

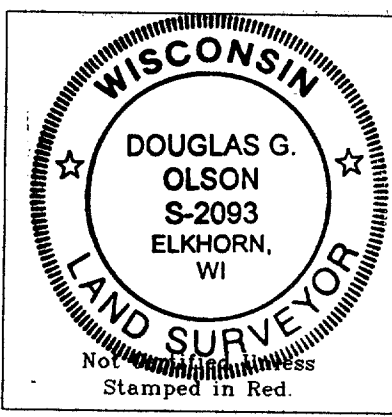

- Notes: 1) This survey plat is not certified unless signed and sealed in red ink.  
2) This survey is subject to Wisconsin lien laws. This Plat of Survey is the notice of intent to file lien. Lien waiver required.

Copyright c 2005 by Jensen & Olson Land Surveying, LLC.  
All rights reserved. No part of this survey plat may be reproduced or transmitted in any form by any means - graphic, electronic, or mechanical, including photocopying, tracing, or information storage and retrieval systems - without permission in writing from Douglas G. Olson, Jensen & Olson Land Surveying, LLC.

I hereby certify that I have surveyed the above described property and the map hereon is correct to the best of my professional knowledge and belief and shows the size and location of the property, its exterior boundaries, the location and dimensions of all visible structures thereon, boundary fences, apparent easements and roadways and visible encroachments, if any.  
This survey is made for the exclusive use of the present owners of property, and also those who purchase, mortgage or guarantee title thereto, within one year from the date hereof.

Douglas G. Olson  
Wisconsin Registered Land Surveyor - 2093

South Street  
(66' Wide)

Concrete Curb & Gutter

(N89°14'55"E 98.00') Sidewalk

N89°14'55"E 98.06'

12' Wide Utility Easement  
As shown on the plat  
of Walton Crest.

N89°14'55"E 97.96'  
(N89°14'55"E 98.00')

Poured  
Concrete  
Foundation

Lot 7  
0.371 Acre  
16,163 Sq.Ft.

Lot 6

Lot 8

(N0°45'05"W 164.95')  
S0°46'24"E 184.90'

(N0°45'05"W 164.93')  
S0°45'05"E 164.88'

5' Wide Private Utility and Drainage Easement  
As shown on the plat of Walton Crest.

Pipe to Pipe=97.82'

N89°14'15"E 97.96'  
(N89°14'15"E 98.00')

N89°14'15"E 98.00'  
(N89°14'15"E 98.00')

Found pipe is  
0.43' S23°50'22"W  
of corner.

(98.00')  
Pipe to pipe=97.87'

Tax Parcel  
/WUP 00315

310-712

WUP 0007