

4040

Job No. 6179

HOWARD E. HANSEN
Wisconsin Land Surveyor
1632 DOUGLAS AVENUE
RACINE, WISCONSIN




HOWARD E. HANSEN
Office Phone MEIrose 7-3346
RACINE, WIS.

PLAT OF SURVEY

OF PROPERTY OF THRIFTY BUILDERS INC.

described as follows: PART OF THE S. 1/2 OF THE NW 1/4 OF SEC.
5 - 4 - 15, WHITEWATER, WALWORTH CO., WIS.

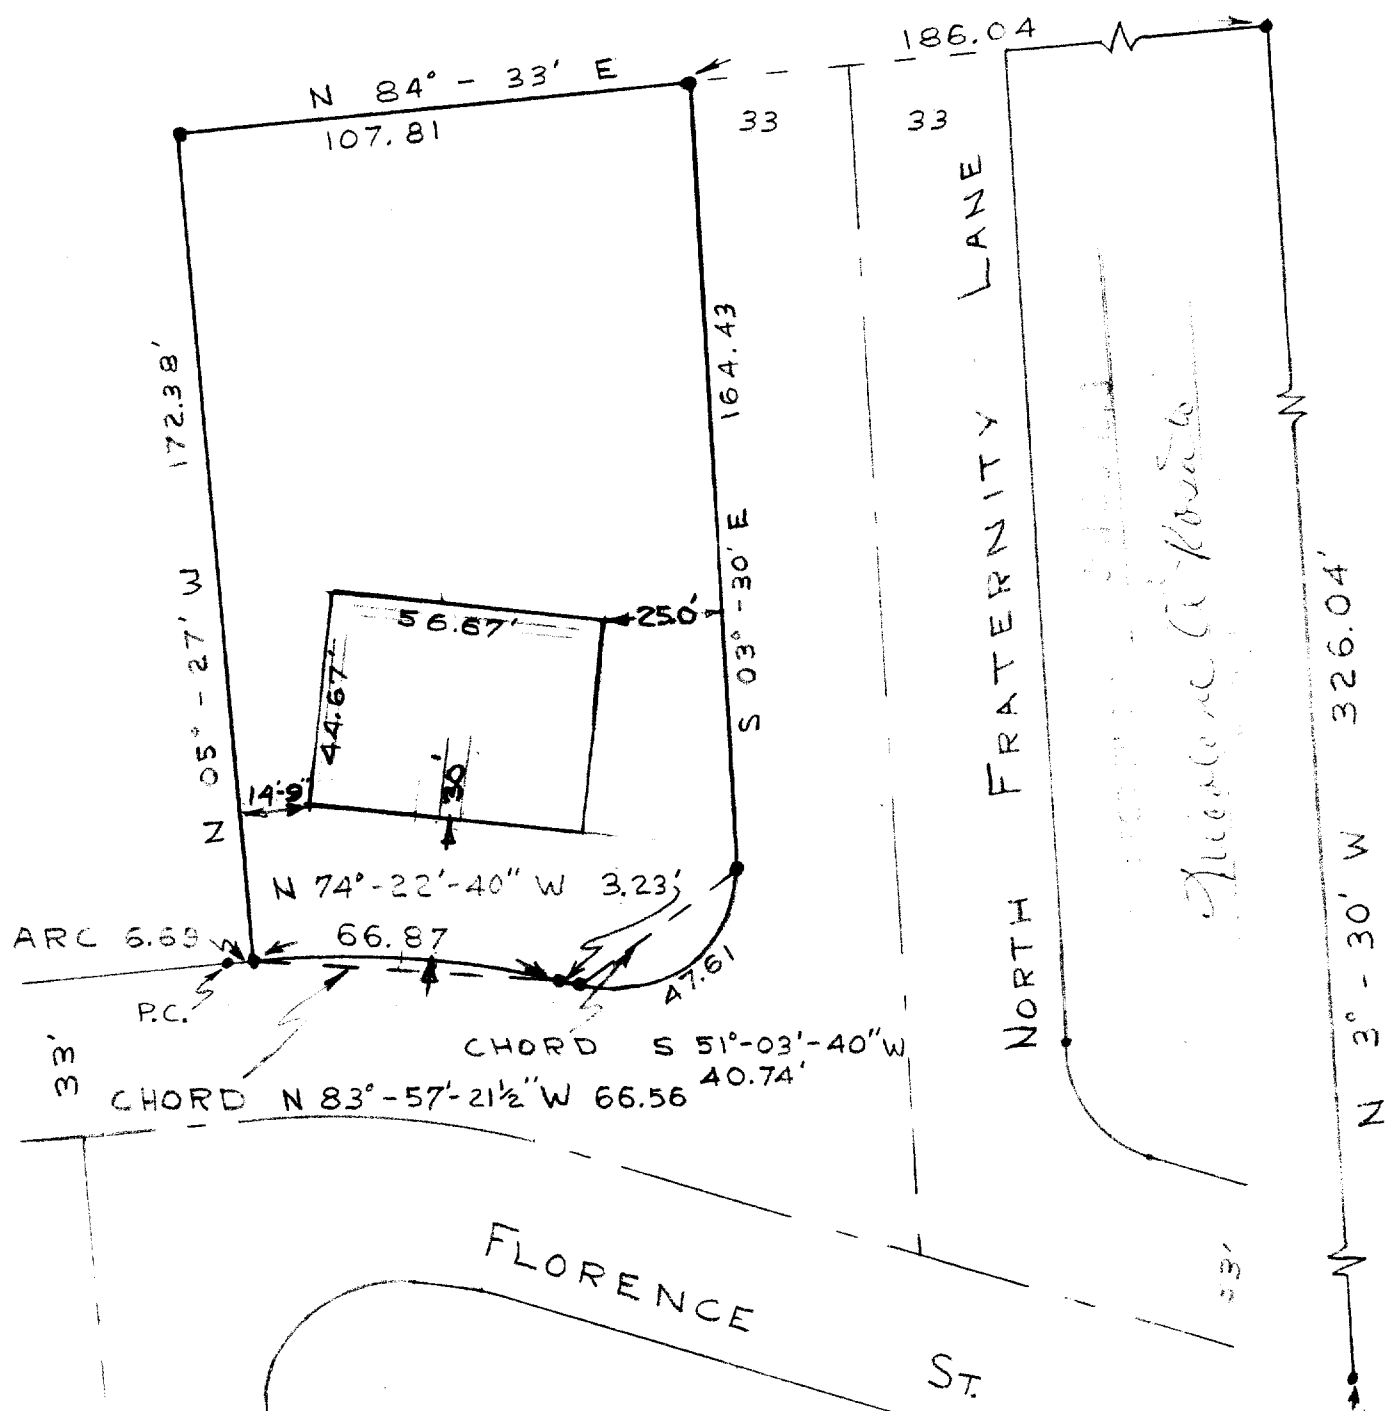

SCALE 1" = 40'
• DENOTES IRON
STAKE

State of Wisconsin
County of Racine

N.W. COR.
ROSE CREST ADD.

I, H. E. HANSEN, do hereby certify that I have surveyed
the property described above according to official records,
and that the plat above drawn is a correct representation
of said survey.

Racine, Wis., 7/17, 1961
Howard E. Hansen

IRCA-24

RACINE COUNTY SURVEYOR FILE NO. 4040
010-779