

4039
2

Job No. 6156

HOWARD E. HANSEN


Wisconsin Land Surveyor
1632 DOUGLAS AVENUE
RACINE, WISCONSIN

Res. Phone MEIrose 4-0565
Office Phone MEIrose 7-3346

PLAT OF SURVEY

OF PROPERTY OF THRIFTY BUILDERS INC.

described as follows: PART OF THE S. 1/2 OF THE N.W. 1/4 OF SEC. 5-TN
4N., R. 15E., CITY OF WHITEWATER, WALWORTH CO., WIS.

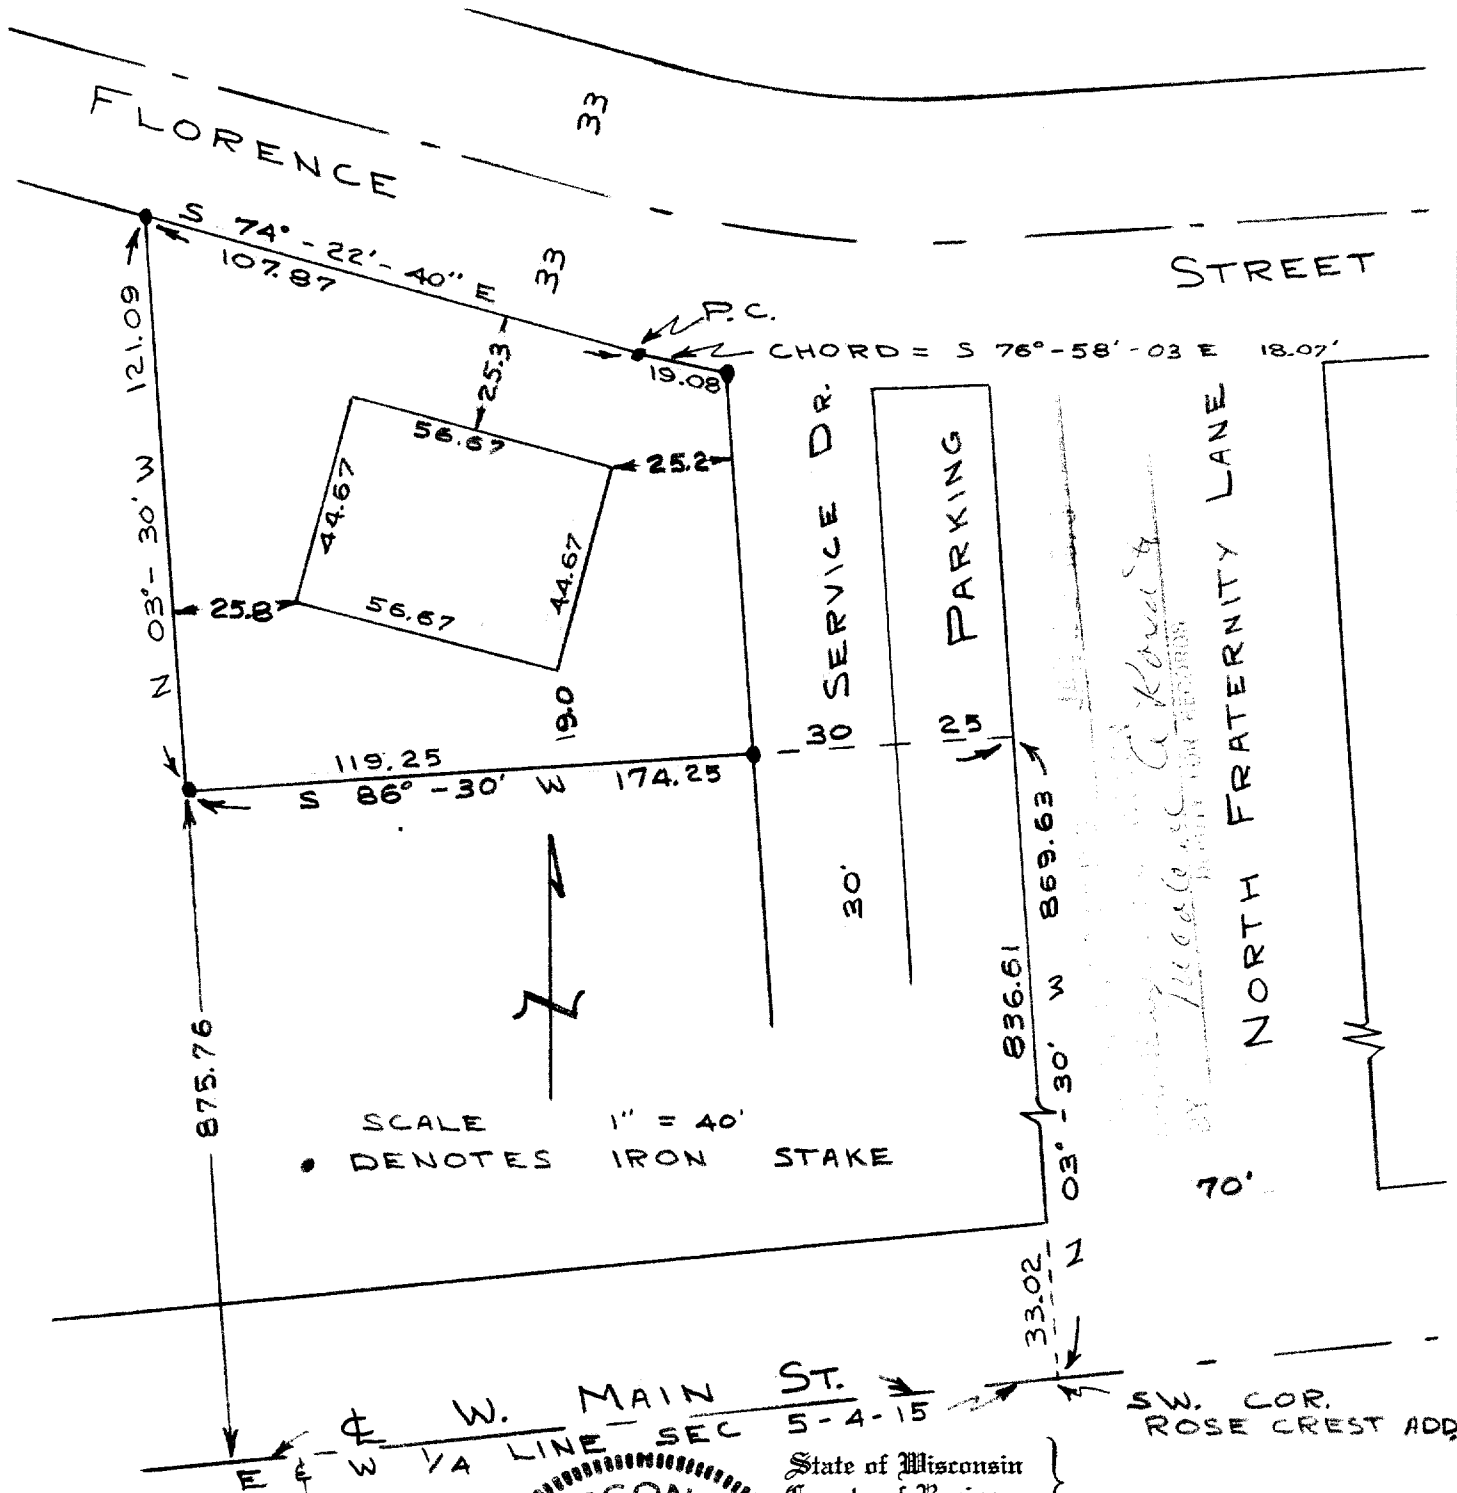

SCALE 1" = 40'
• DENOTES IRON STAKE

W. MAIN ST.
SEC 5-4-15
E & W 1/4 LINE


SW. COR.
ROSE CREST ADD

State of Wisconsin
County of Racine

I, H. E. HANSEN, do hereby certify that I have surveyed
the property described above according to official records,
and that the plat above drawn is a correct representation
of said survey.

Racine, Wis., 7/17, 1961

Howard E. Hansen

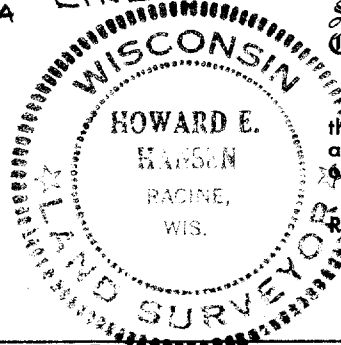

RECEIVED
JUL 25 1961

RACINE COUNTY CLERK FILE NO. 4039
C/O-780