


P R A T T

S T R E E T

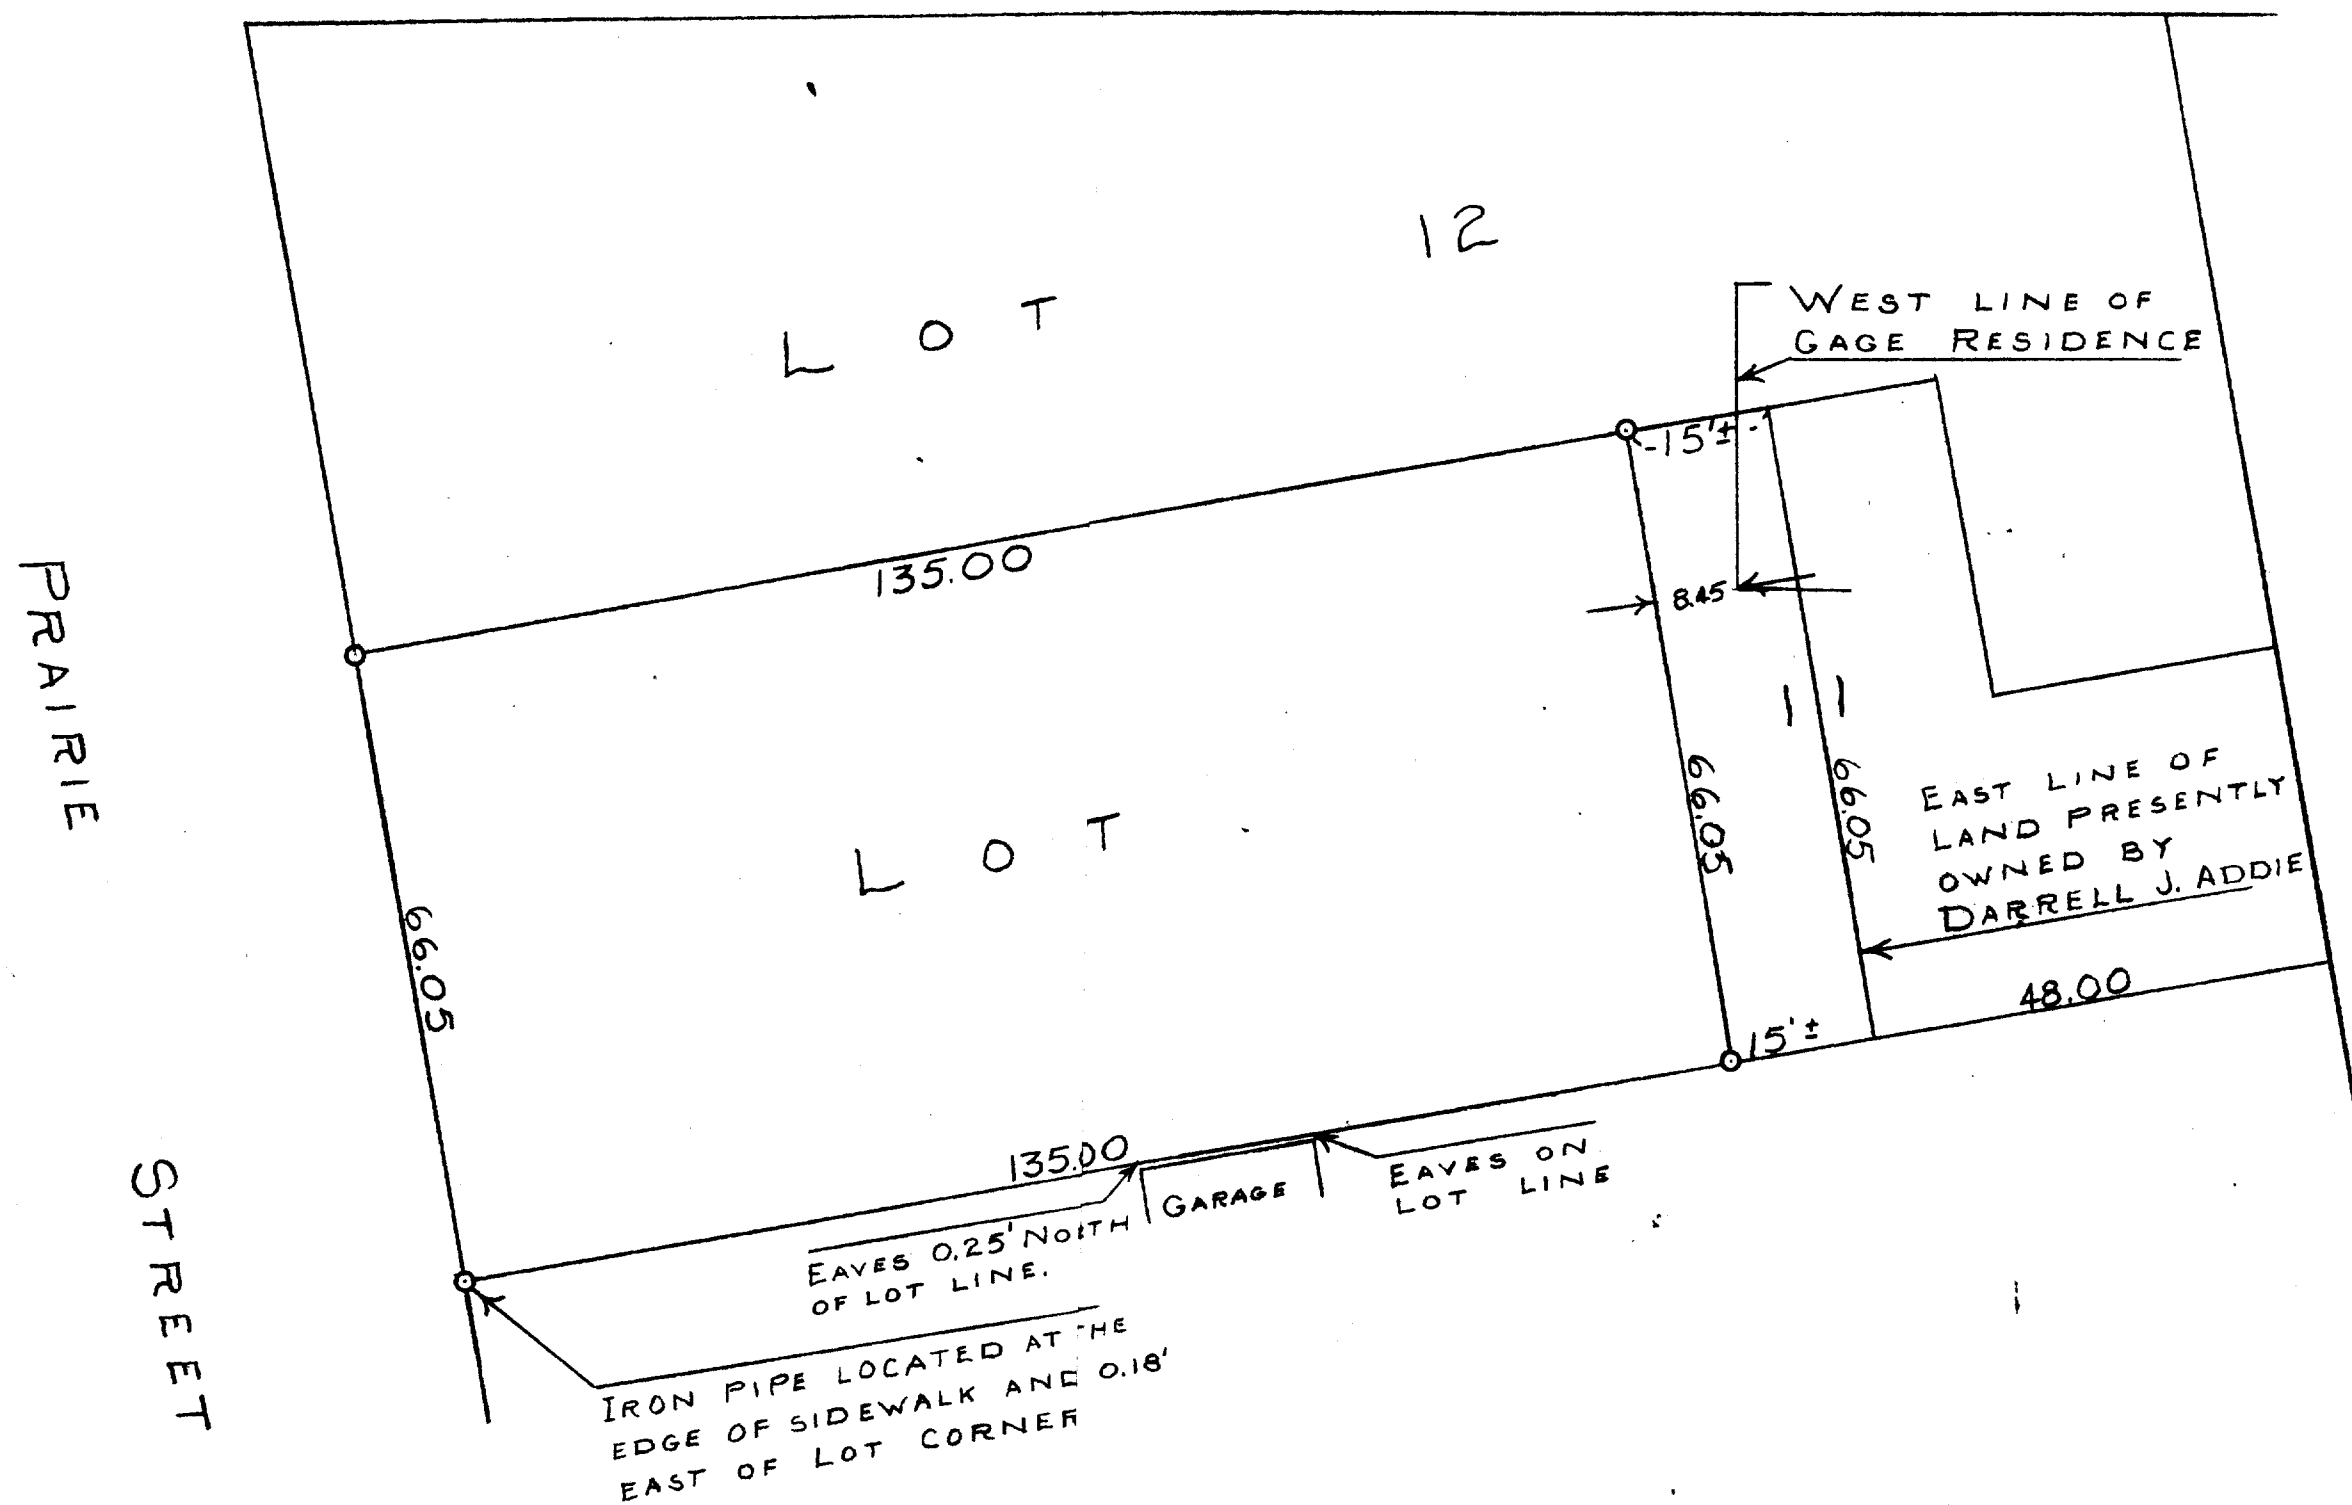

N

P R A I R I E

S T R E E T

SCALE 1"=20'
O=IRON PIPE

PLAT OF SURVEY OF PART OF LOT 11 BULKLEY AND TRATT'S
ADDITION TO THE CITY OF WHITEWATER, WALWORTH COUNTY,
WISCONSIN.
JAN. 6, 1955

George T. Dunham
GEORGE T. DUNHAM, SURVEYOR
DELAYAN, WISCONSIN

BUL. 12

10-8