



PLAT OF SURVEY

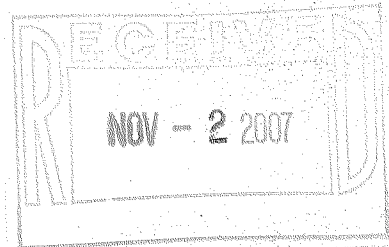

LEGAL DESCRIPTION

A PART OF THE NW 1/4 SEC. 5, T4N, R15E, IN THE CITY OF WHITEWATER, WALWORTH CO. WISCONSIN, DESCRIBED AS FOLLOWS:


BEGINNING IN THE CENTER OF THE STREET AT THE SW CORNER OF LAND OWNED BY MARY LUGG, WHICH POINT IS 14 RODS WEST OF THE N/S 1/4 LINE AND 46 RODS NORTH OF THE E/W 1/4 LINE SAID SECTION; THENCE N 2°15'45" E (PREVIOUSLY RECORDED AS PARALLEL TO SAID N/S 1/4 LINE), 163.00 FEET; THENCE N 89°31'54" W, 82.46 FEET; THENCE S 2°17'57" W, 163.00 FEET, TO THE CENTER OF THE STREET; THENCE S 89°31'45" E, 82.57 FEET (RECORDED AS 82.5 FEET), TO THE POINT OF BEGINNING.

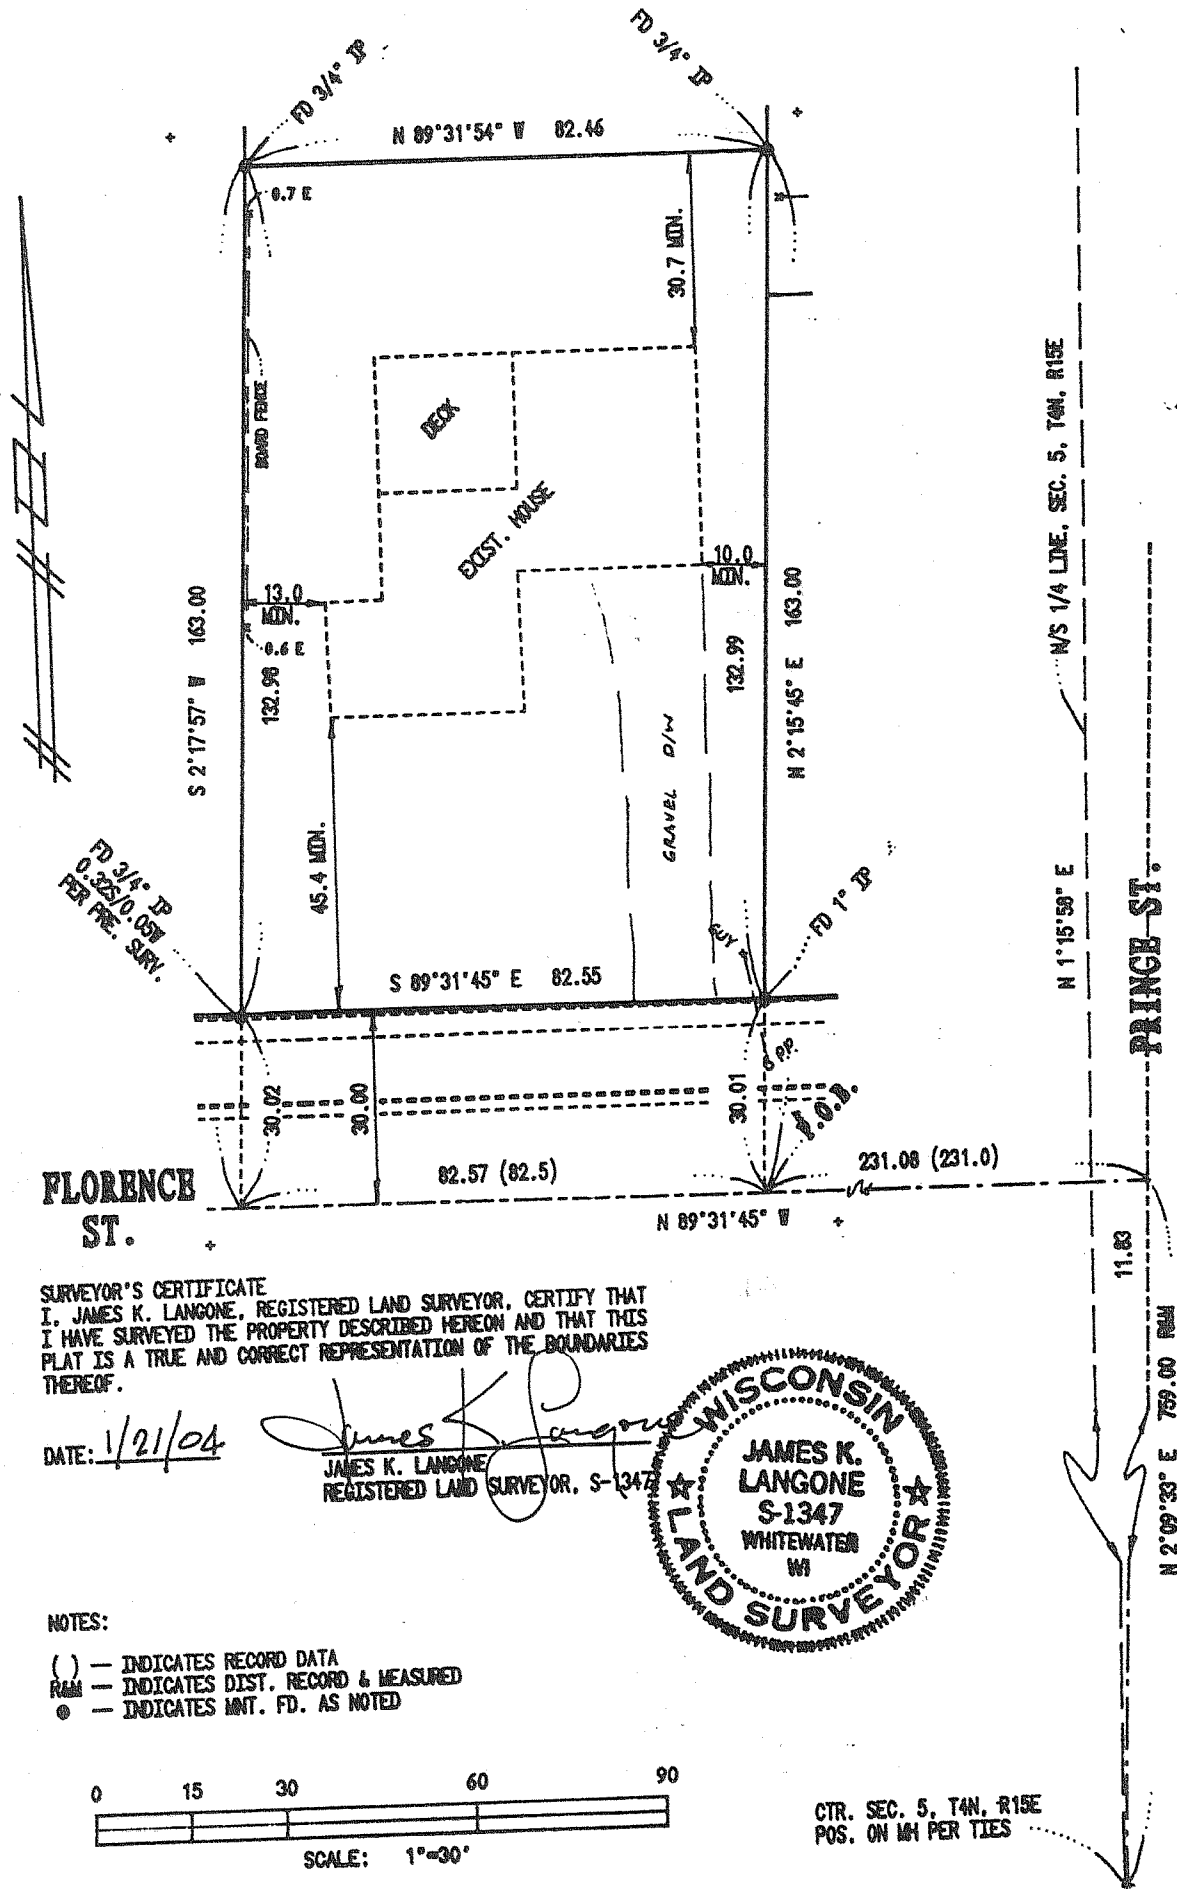

SURVEYOR'S CERTIFICATE
I, JAMES K. LANGONE, REGISTERED LAND SURVEYOR, CERTIFY THAT I HAVE SURVEYED THE PROPERTY DESCRIBED HEREON AND THAT THIS PLAT IS A TRUE AND CORRECT REPRESENTATION OF THE BOUNDARIES THEREOF.


DATE: 1/21/04

JAMES K. LANGONE
REGISTERED LAND SURVEYOR, S-1347

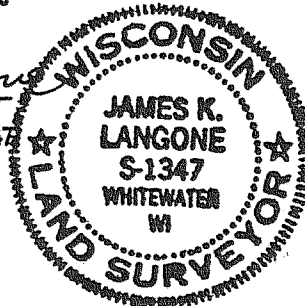

NOTES:

- () — INDICATES RECORD DATA
- RAM — INDICATES DIST. RECORD & MEASURED
- — INDICATES MNT. FD. AS NOTED

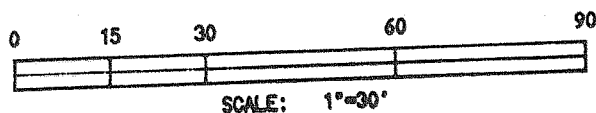

CTR. SEC. 5, T4N, R15E
POS. ON MN PER TIES

JAMES K. LANGONE
LAND SURVEYS & CIVIL ENGINEERING

1839 Co. Rd. "N" (Upper)

Whitewater, WI. 53190-2842

(262) 473-4119

JN: 04-101
01/21/04

WUP - 179

010-837