




SCALE 1" = 20'
 O = IRON PIPE

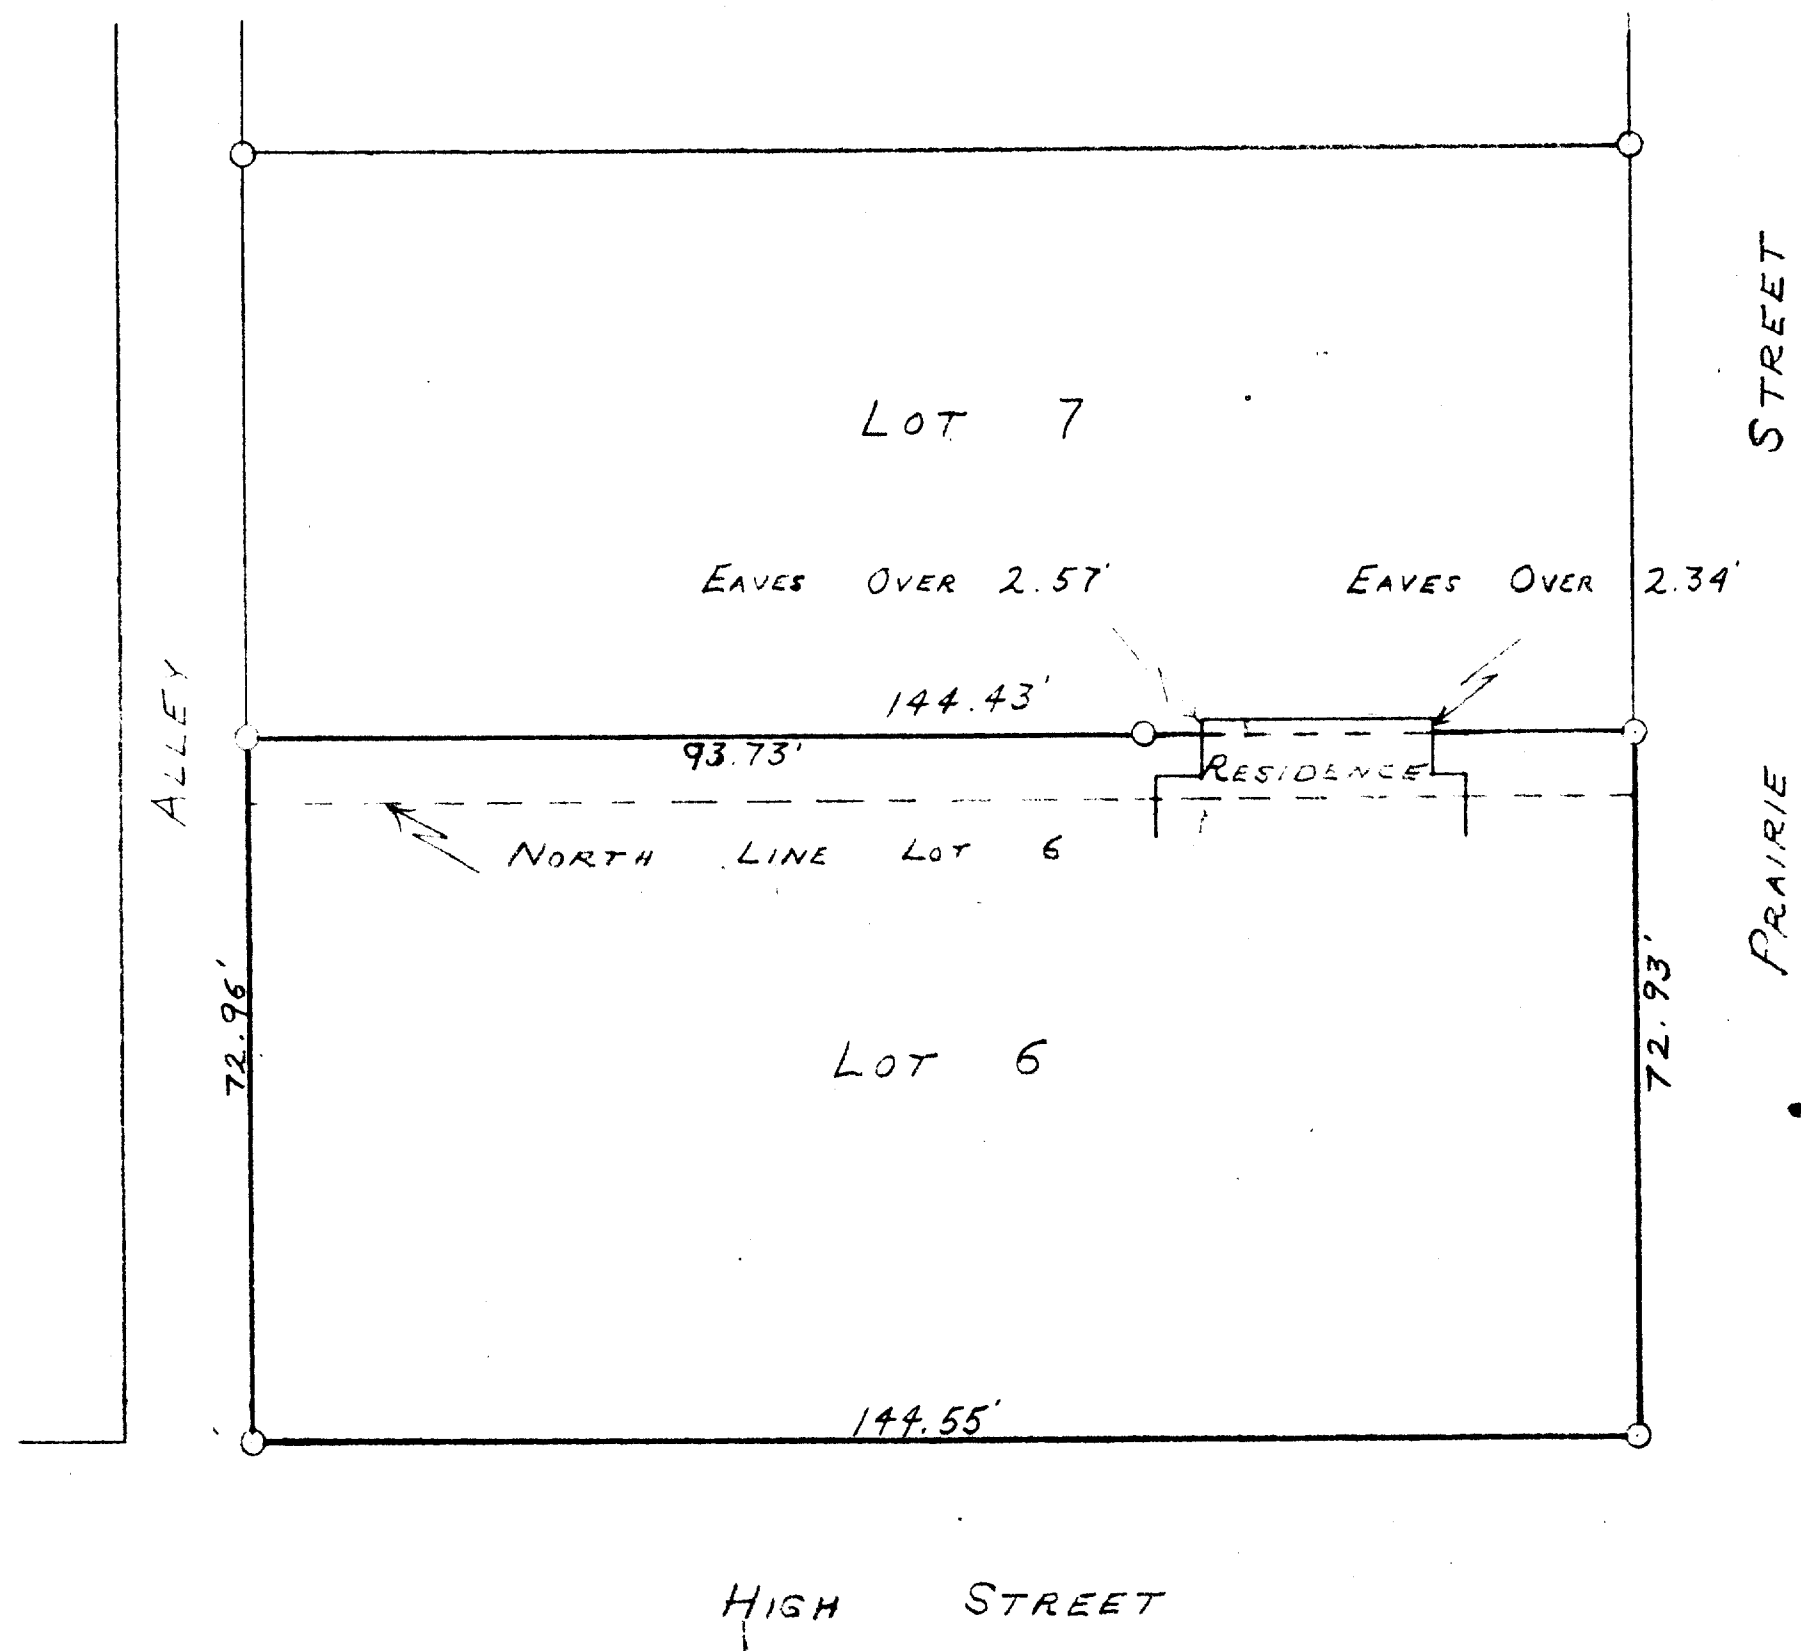

PLAT OF SURVEY OF LOT 6 AND PART
 OF LOT 7 BLOCK 20 CHAPMAN AND LUDINGTON'S
 ADDITION LOCATED IN THE CITY OF WHITEWATER
 WALWORTH COUNTY, WISCONSIN
 MAY 9, 1952

Lloyd S. Jensen
 WALWORTH COUNTY SURVEYOR

CL-31

10-84 J