
DESCRIPTION:

ALL OF LOT 34 OF PINE BLUFF ADDITION NO. 1, AS DULY RECORDED IN WALWORTH COUNTY RECORDS AND LOCATED IN THE SOUTHEAST 1/4 OF THE SOUTHEAST 1/4 OF SECTION 3, TOWNSHIP 4 NORTH, RANGE 15 EAST, CITY OF WHITEWATER, WALWORTH COUNTY, WISCONSIN.



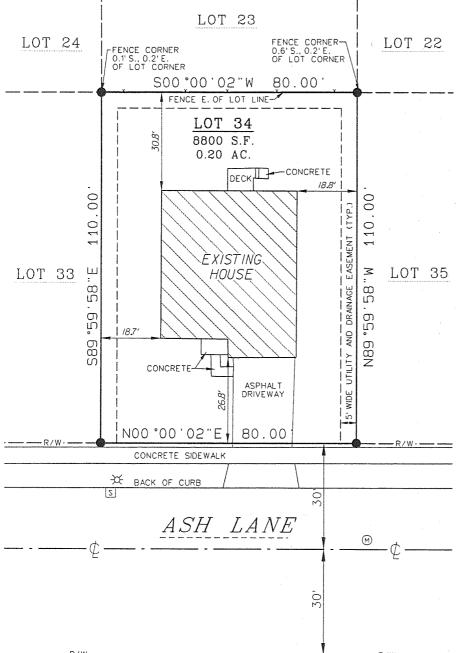

BASIS OF BEARING:
THE WEST LINE OF
LOT 34 WAS TAKEN
TO BEAR NOO° 00'02"E.

LEGEND:

● 1" IRON PIPE FOUND

R/W RIGHT-OF-WAY

CENTERLINE

SEWER MANHOLE

STORM SEWER INLET

LIGHT POLE


NOTE:

ADDN.

Kennedy Homes Whitewater Surveys/1 - Cad/Base/07153 SURVEY LOT

Projects\2007\07-153

NO TITLE COMMITMENT OR RESULTS OF A TITLE SEARCH WERE FURNISHED TO RSV ENGINEERING, INC., PERTAINING TO THIS SURVEY. THIS PLAT OF SURVEY MAY NOT REFLECT EASEMENTS OF RECORD, ENCUMBRANCES, RESTRICTIONS, OWNERSHIP TITLE EVIDENCE, OR OTHER FACTS THAT AN ACCURATE AND CURRENT TITLE SEARCH MAY DISCLOSE.

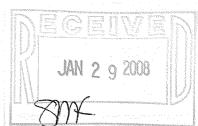

SURVEY DATE: 11/08/2007 SURVEY MADE FOR: KENNEDY HOMES C/O RICHARD BATES

C/O RICHARD BATES
14 EXECUTIVE CT.
SOUTH BARRINGTON, IL 60010

ENGINEERING, INC. W232 \$7530 BIG BEND DRIVE BIG BEND, WI 53103 (262) 662-4292 THIS SURVEY IS MADE FOR THE USE OF THE PRESENT OWNERS OF THE PROPERTY, AND ALSO THOSE WHO PURCHASE, MORTGAGE OR GUARANTEE TITLE TO WITHIN ONE (1) YEAR FROM DATE HERETO.

I, KENNETH B. MEHRING R.L.S. *2838, HEREBY CERTIFY
THAT THIS SURVEY WAS MADE IN ACCORDANCE WITH
THE MINIMUM STANDARDS FOR PROPERTY SURVEYS
(CHAPTER A-E 7) FOR THE STATE OF WISCONSIN AND
HAS BEEN PREPARED UNDER MY DIRECTION AND
CONTROL AND IS CORRECT TO THE BEST OF MY
KNOWLEDGE AND BELIEF. (ORIGINAL

Kenneth B. Mehring
S-2838
Waterford
WIS.

NAL ONLY IF SEAL IS RED)

PLOT DATE: 11/8/2007

RSV JOB*: 07-153 KENNEDY HOMES