



PLAT OF SURVEY
LOT 41 AND THE WEST 6 FEET OF LOT 42 IN HANFORD A. CONGER'S SUBDIVISION OF BLOCK 6 OF
BIRGE'S ADDITION TO THE VILLAGE NOW CITY OF WHITEWATER, Walworth County, Wisconsin.

Surveyed for: Tincher Realty
Survey Address: 928 Highland Street

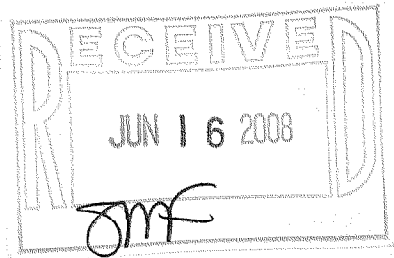


- FOUND 1" IRON PIPE
- FOUND 3/4" PIN
- ✱ FOUND RR SPIKE
- () RECORDED AS DIMENSIONS

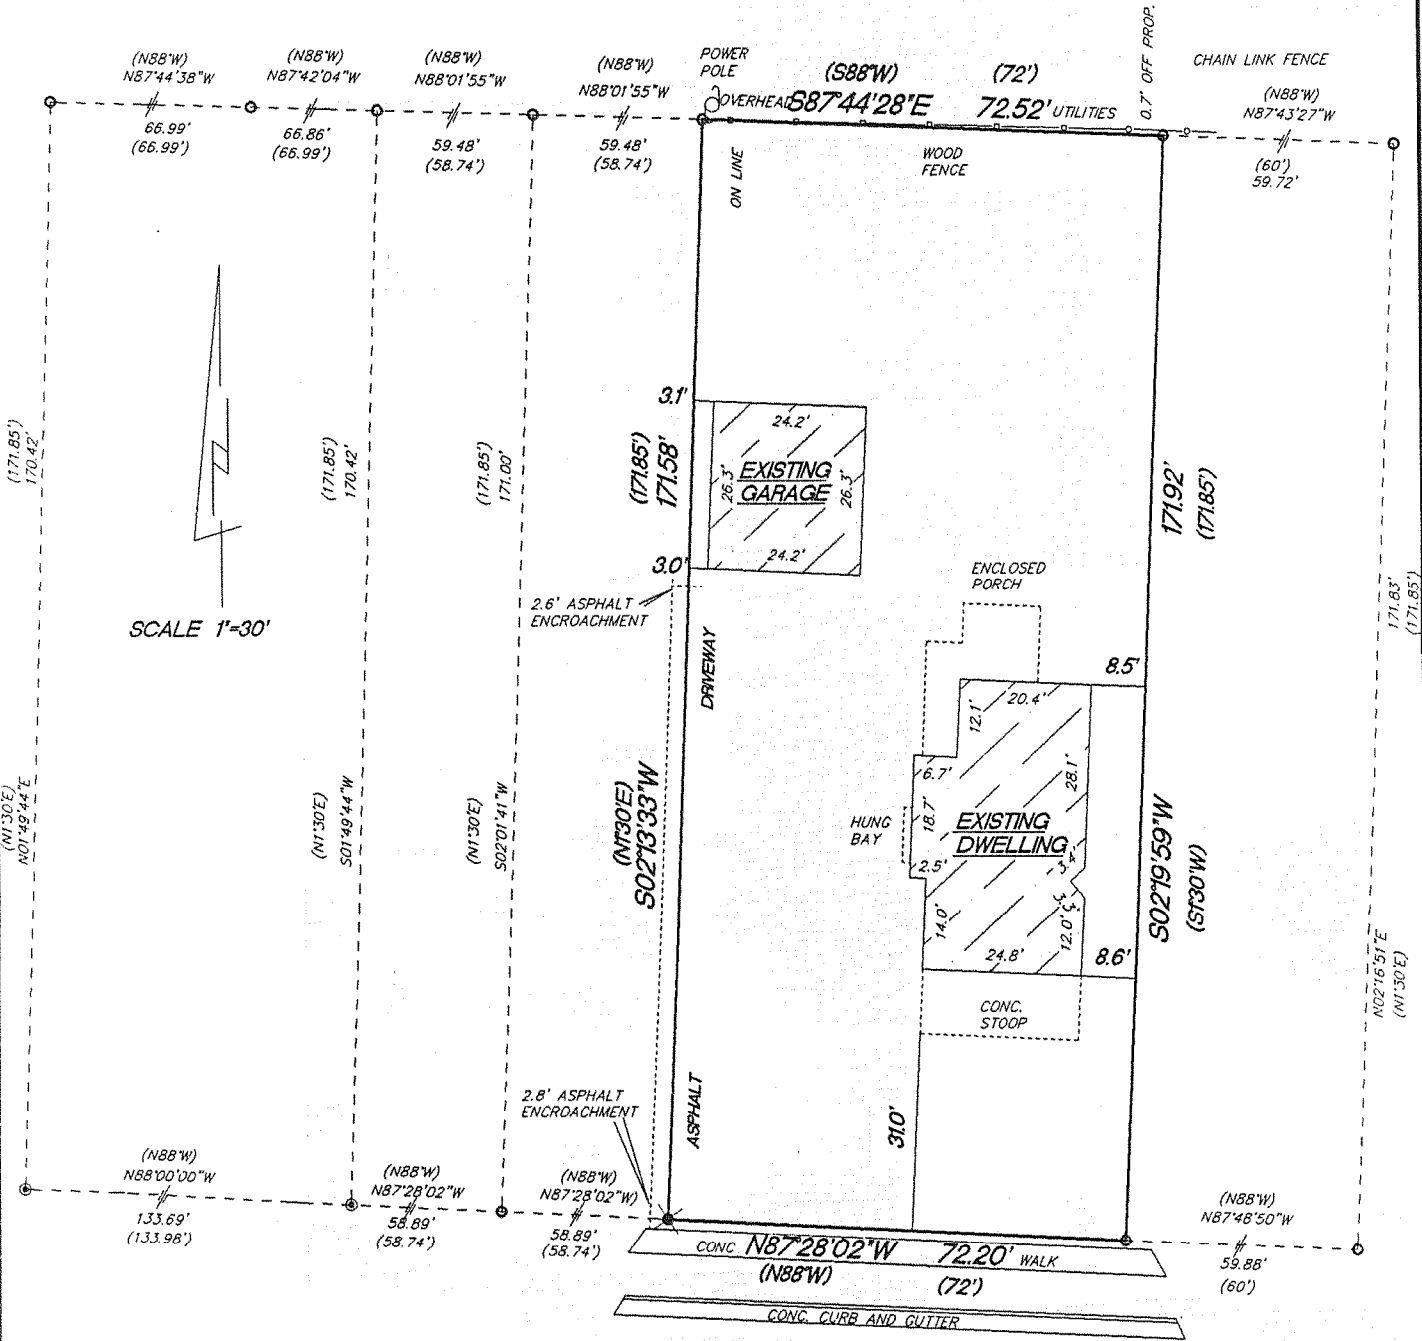

"I hereby certify that I have surveyed the above described property and that the above map is a true representation thereof and shows the size and location of the property, its exterior boundaries, the location of all visible structures and dimension of all principal buildings thereon, boundary fences, apparent easements, roadways and encroachments if any."
"This survey is made for the use of the present owners of the property, and also those who purchase, mortgage or guarantee the title thereto within one year from date hereof."

KETTLE MORaine SURVEYING INC.
S75 W36245 Wilton Road
Eagle Wisconsin 53119
P.O. Box 357
(262) 594-3484
Terrance E. Pisarek R.L.S.

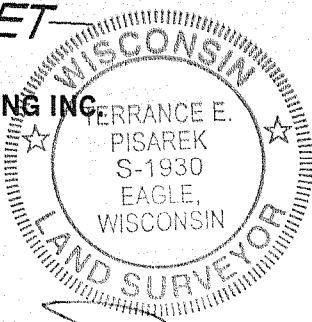

THIS IS NOT AN ORIGINAL SURVEY UNLESS THE SEAL IS RED.

6/11/08	TEP	TEP	08050
DATE	FIELD WORK BY	DRAWN BY	JOB NUMBER

1CON - 29 010 - 857