


SCALE - 1" = 30'
 ● = IRON ROD
 ○ = IRON PIPE
 X = CROSS IN CONC

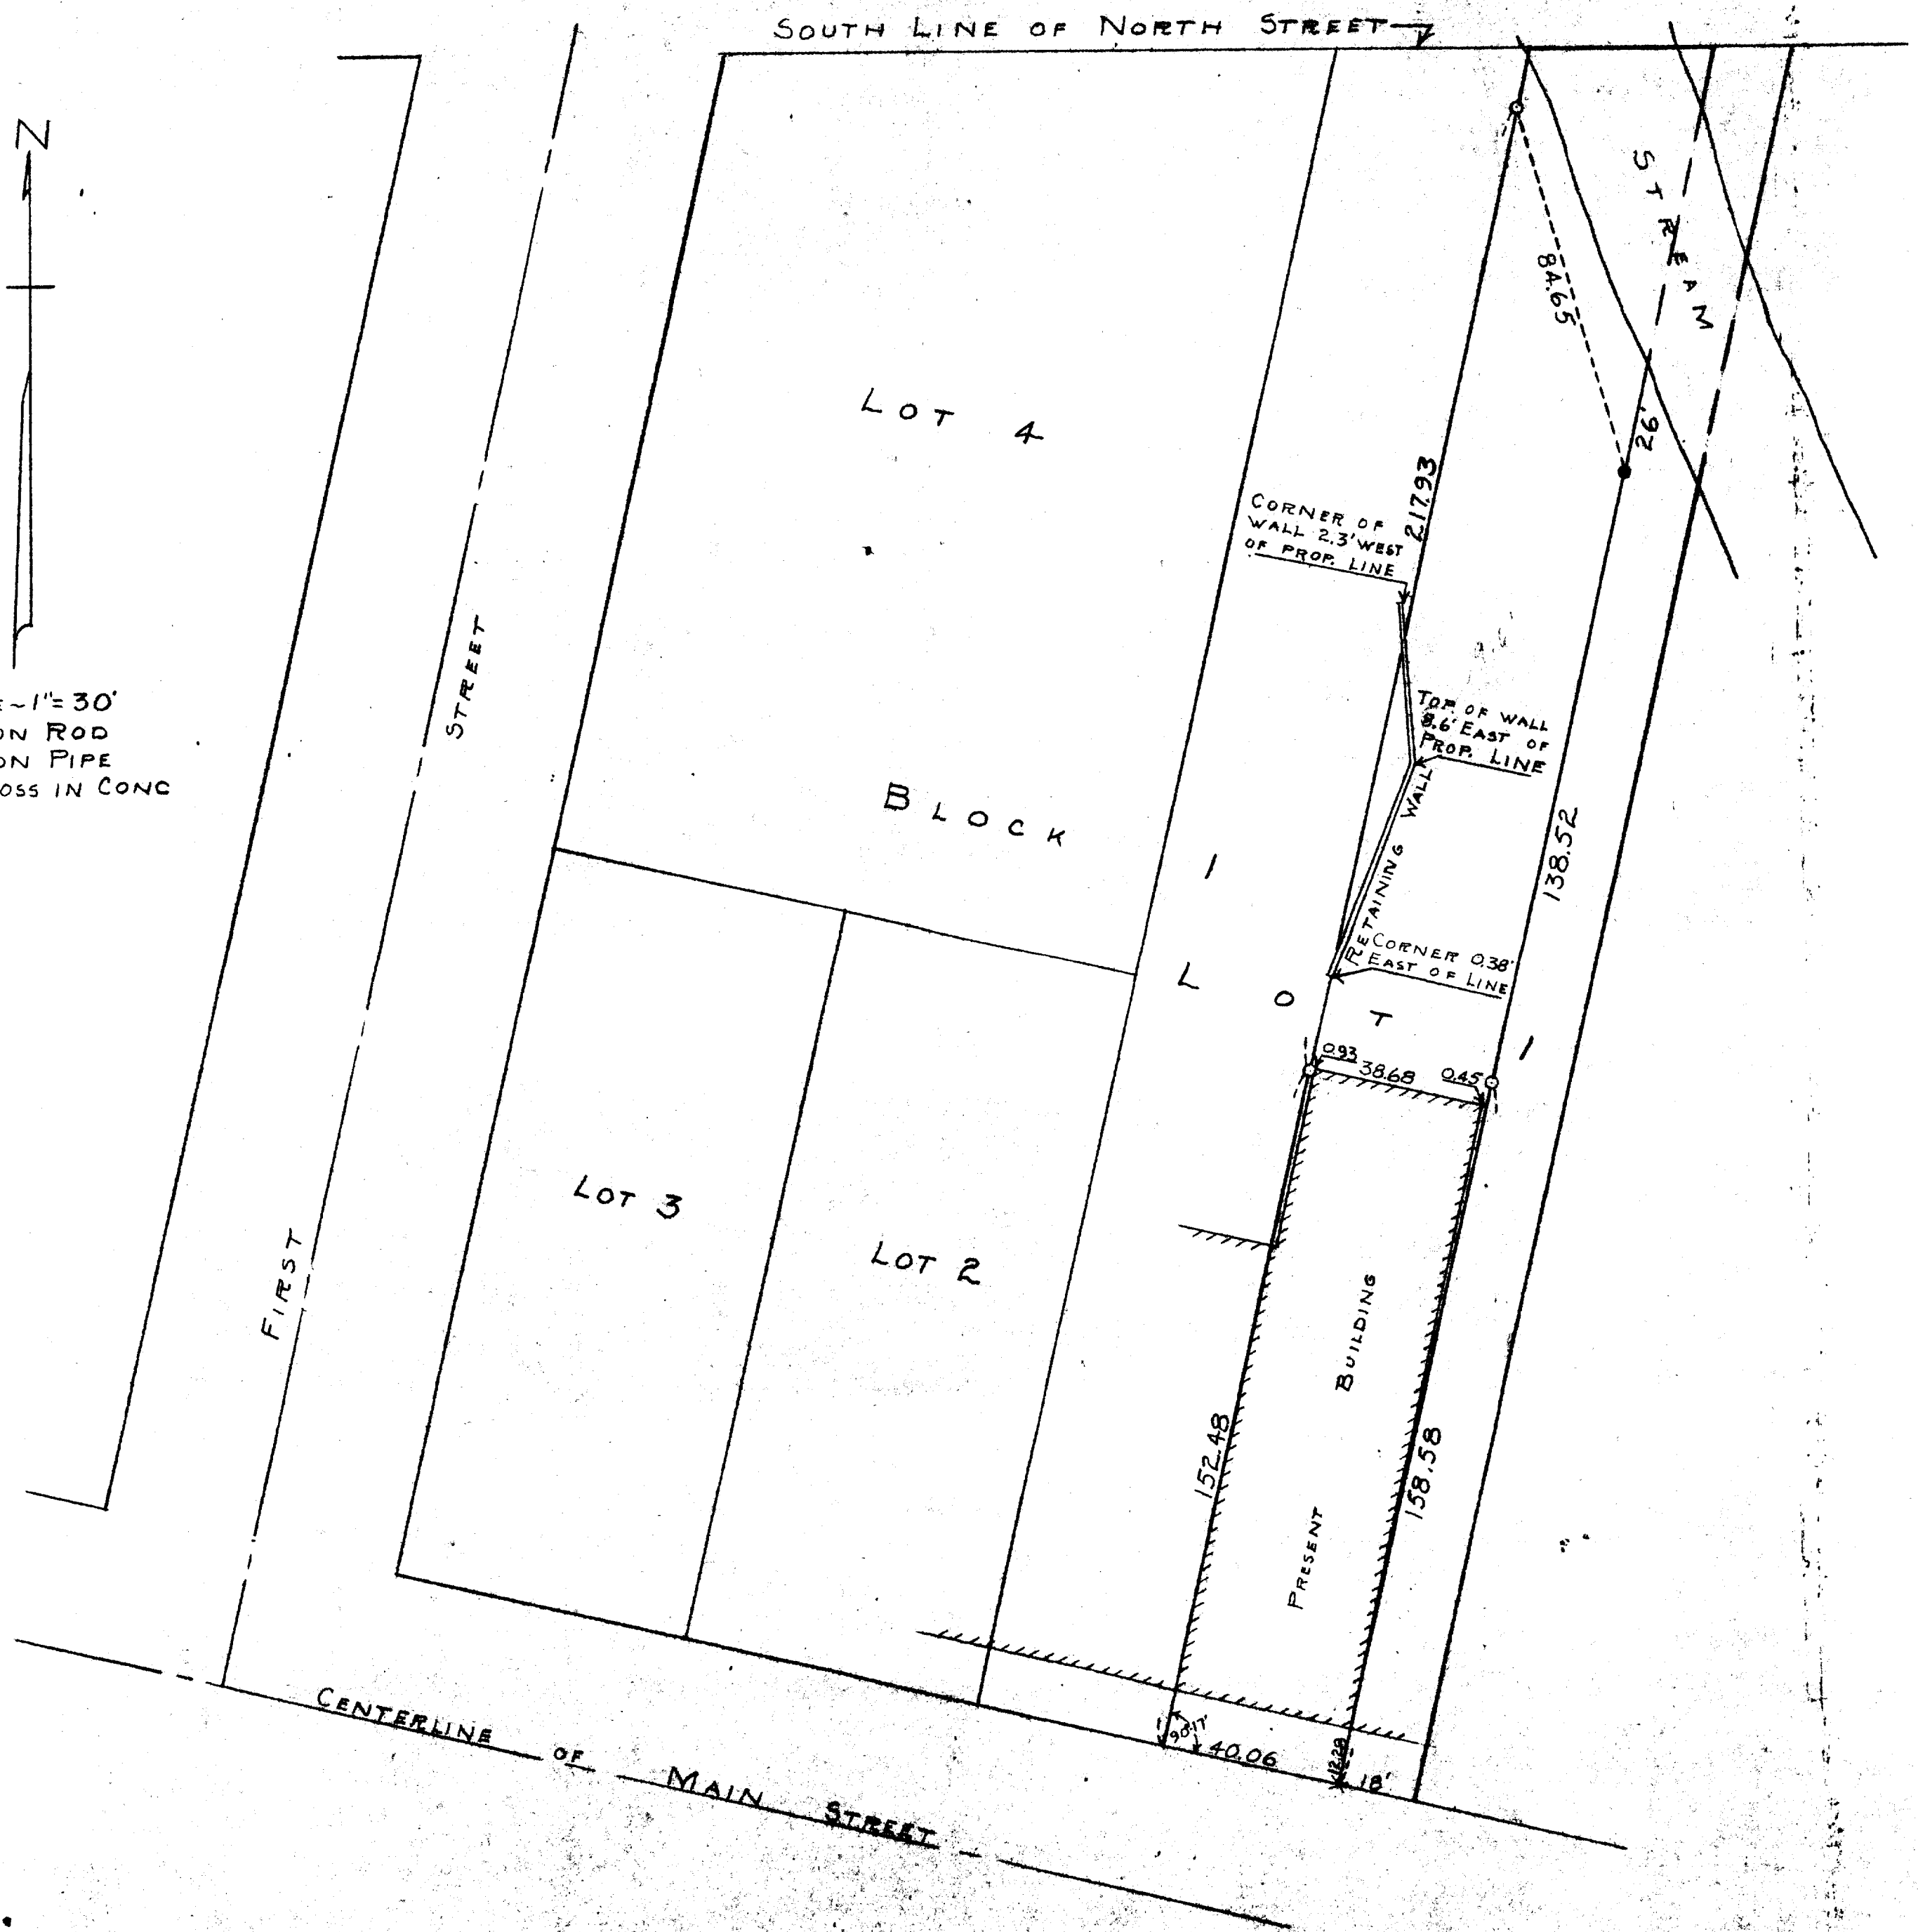

PLAT OF SURVEY OF PART OF LOT 1, BLOCK 1, OF THE ORIGINAL PLAT IN THE
 CITY OF WHITEWATER, WALWORTH COUNTY, WISCONSIN
 FEBRUARY 16, 1953

GEORGE T. DUNHAM, SURVEYOR
 DEKAY, WISCONSIN

10-9

OT-3