

LAND-MARK SURVEYING



Mark L. Miritz
Wisconsin Registered Land Surveyor S-2582

N9330 Knuteson Drive
Whitewater, WI 53190
Phone: (262)495-3284
FAX: (262)495-8421
LAND-MARKSURVEYING.COM

PLAT OF SURVEY

LOT 1 OF CLARKE'S ADDITION TO THE CITY OF WHITEWATER,
EXCEPTING THE NORTH 79.5 FEET, LOCATED IN THE NORTHWEST
1/4 OF SECTION 4, TOWN 4 NORTH, RANGE 15 EAST, CITY OF
WHITEWATER, WALWORTH COUNTY, WISCONSIN.

THE EAST-WEST 1/4 SECTION LINE OF
SEC. 4-4-15 WAS ASSUMED TO BEAR
N 84°42'00" E AS PER DEED #746330

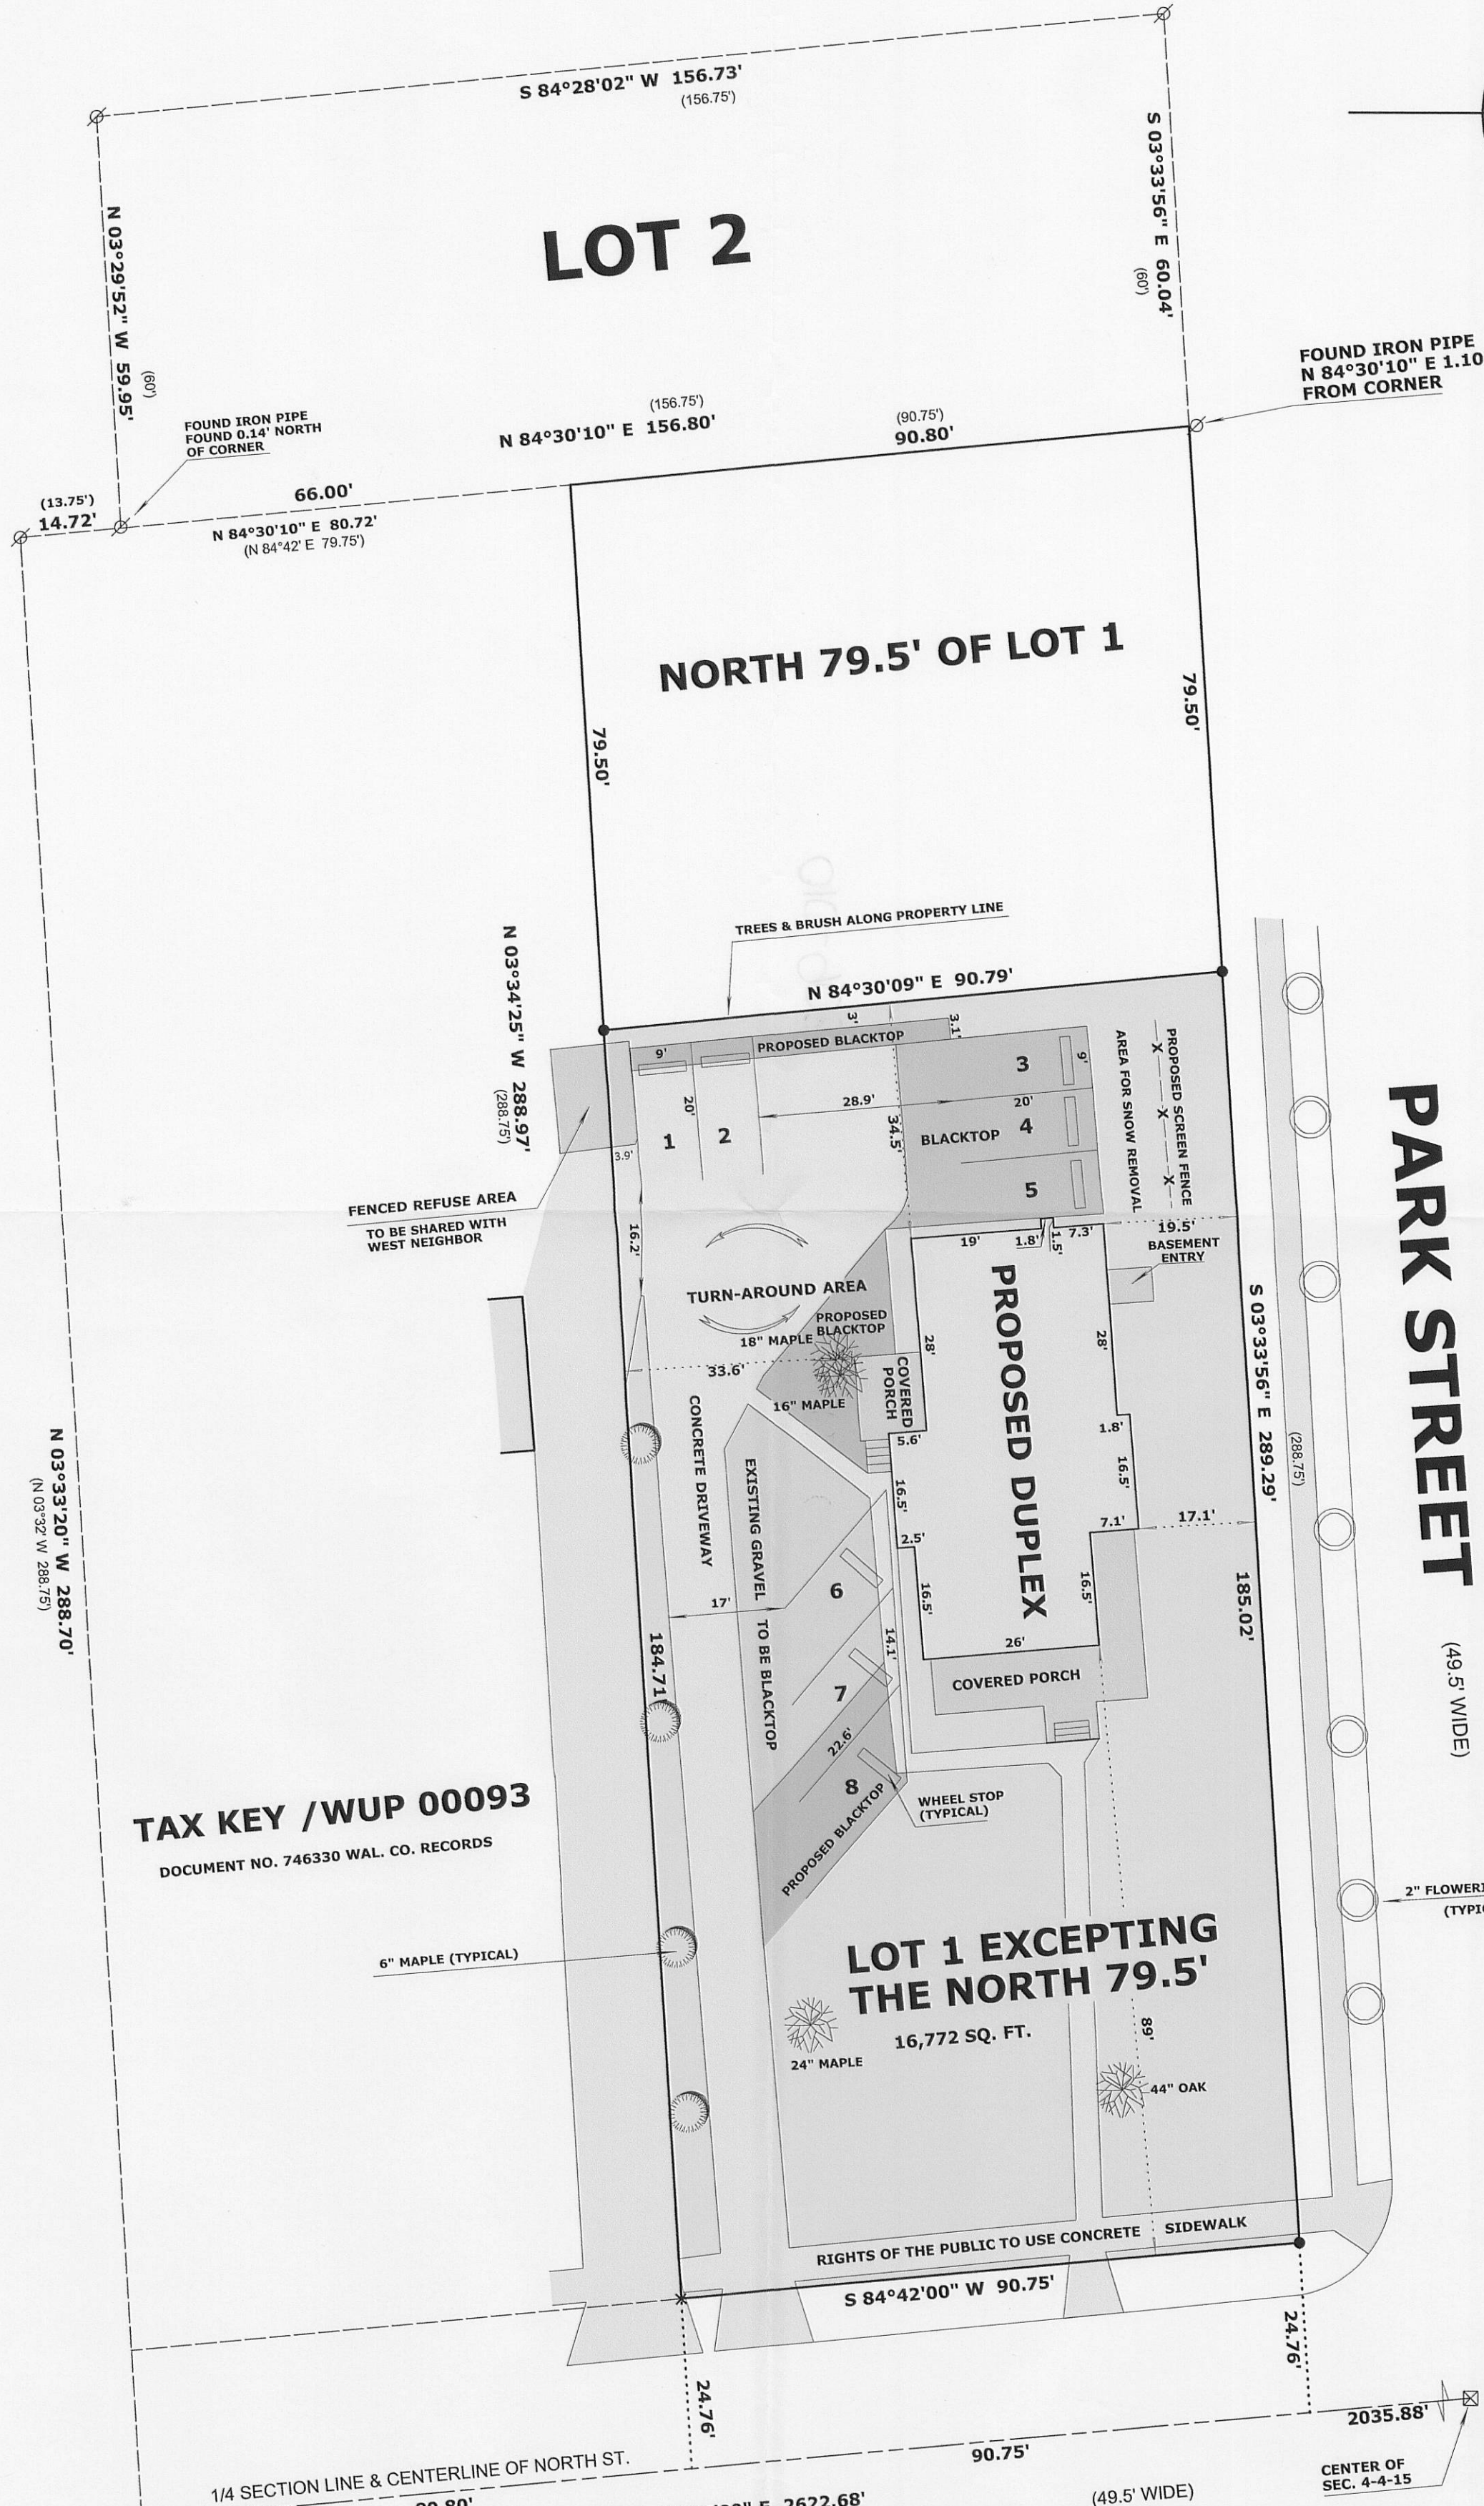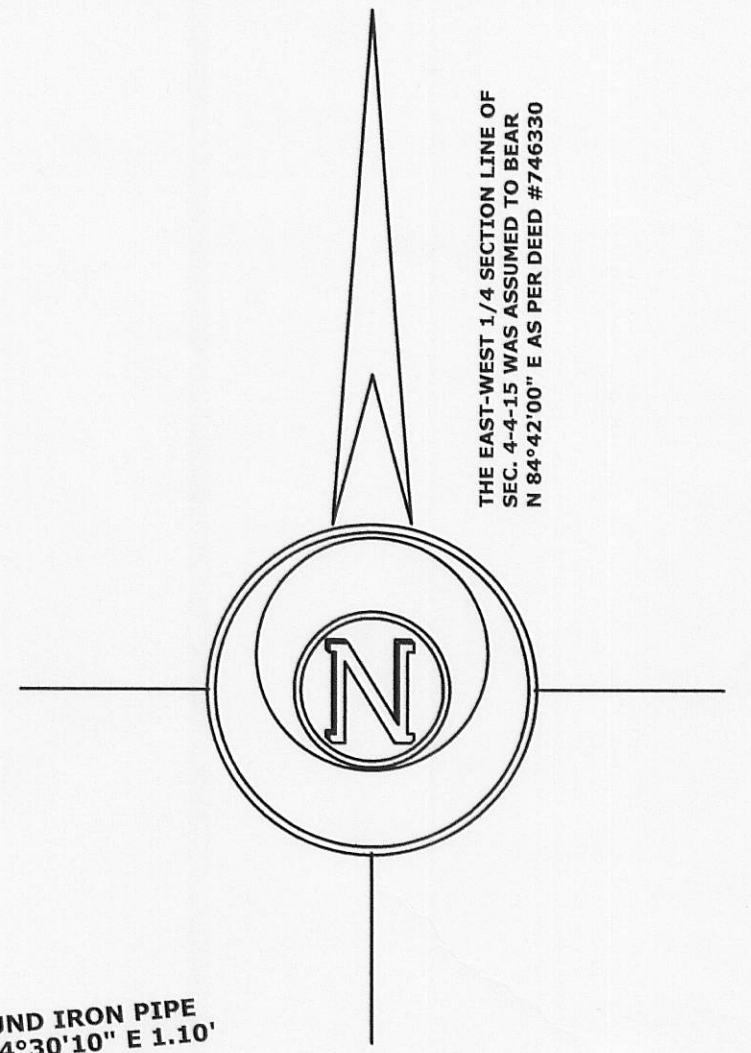

- LEGEND**
- FOUND IRON PIPE
 - FOUND IRON ROD
 - FOUND COUNTY MONUMENT
 - SET CUT CROSS IN CONCRETE
 - SET IRON PIPE, 18" LONG, WEIGHING 1.5 LBS./LINEAL FT., 1 1/4" DIA.
 - RECORDED AS DIMENSION

SCALE: 1 INCH = 20 FEET

"I hereby certify that the above described property has been surveyed by me or under my direction and that the above map is a true representation thereof and shows the size and location of the property, its exterior boundaries, the location of all visible structures and dimensions of all principal buildings thereon, boundary fences, apparent easements, roadways and visible encroachments, if any. This survey is made for the use of the present owners of the property, and also those who purchase, mortgage, or guarantee the title thereto within one year from date hereof."

MARK L. MIRITZ
WISCONSIN REGISTERED
LAND SURVEYOR S-2582

DATE: OCT. 9, 2010 JOB NO. 10.910

