


Plat of Survey

All that part of the South 76 1/2 feet of the North 1/2 of Lot 3, Block 3, in Birge's Addition to the City of Whitewater, described as follows: Beginning at the Southwest corner of the North 1/2 of said Lot 3; thence North along the East side of Prince Street, 4.00 feet; thence South 89°56'13" East, 77.16 feet; thence South 00°01'19" East, 1.88 feet to the South line of the North 1/2 of said Lot 3; thence South 88°29'14" West along said South line, 77.19 feet to the point of beginning, containing 227 square feet, located in the Southwest 1/4 of the Southeast 1/4 of Section 5, Town 4 North, Range 15 East, City of Whitewater, Walworth County, Wisconsin.

Surveyed for: Mike Grubb

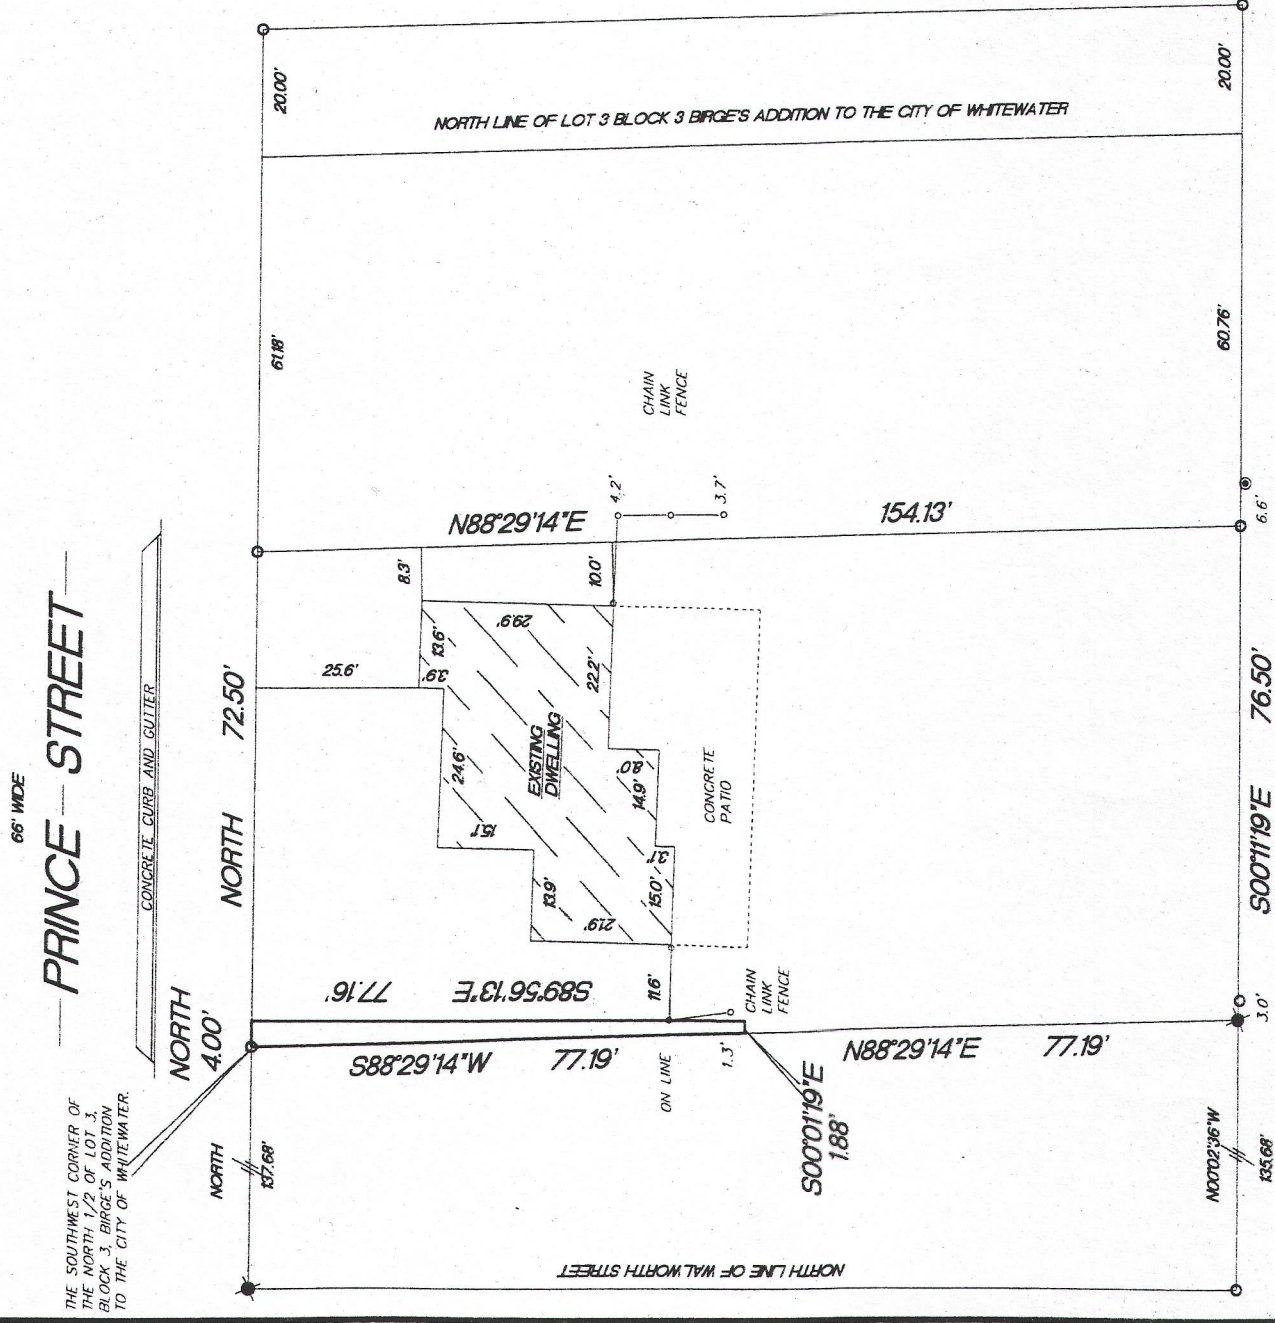

FOUND AXEL ROD


FOUND 1" IRON PIPE

FOUND PIN

MONUMENTATION WAS WAIVED BY CLIENT
IN ACCORDANCE WITH A-E.01(2) OF THE
WISCONSIN ADMINISTRATIVE CODE.

SCALE 1"=30'

BEARINGS ARE REFERENCED TO THE EAST LINE OF PRINCE STREET AND ASSUMED TO BEAR NORTH

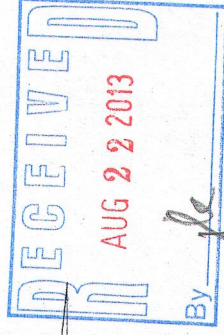

"I hereby certify that I have surveyed the above described property and that the above map is a true representation thereof and shows the size and location of the property, its exterior boundaries, the location of all visible structures and dimensions of all principal buildings thereon, boundary fences, apparent easements, roadways and encroachments if any."

"This survey is made for the use of the present owners of the property, and also those who purchase, mortgage or guarantee the title thereto within one year from date hereof."

KETTLE MORaine SURVEY
S75 W36245 Wilton Road
Eagle Wisconsin 53119
P.O. Box 357
(262) 594-3484
kettlemorainesurvey.com
Terrance E. Pisarek R.L.S.



THIS IS NOT AN ORIGINAL SURVEY UNLESS THE SEAL IS RED

8/20/13

TFP

DATE _____

FIELD WORK BY

DRAWN BY

JOB NUMBER

1BTR-38B

010-938