
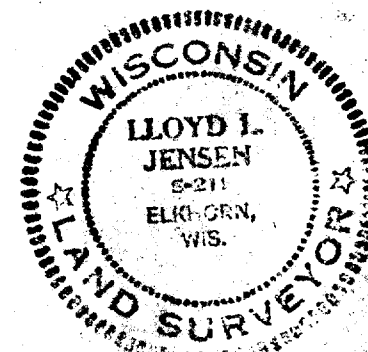


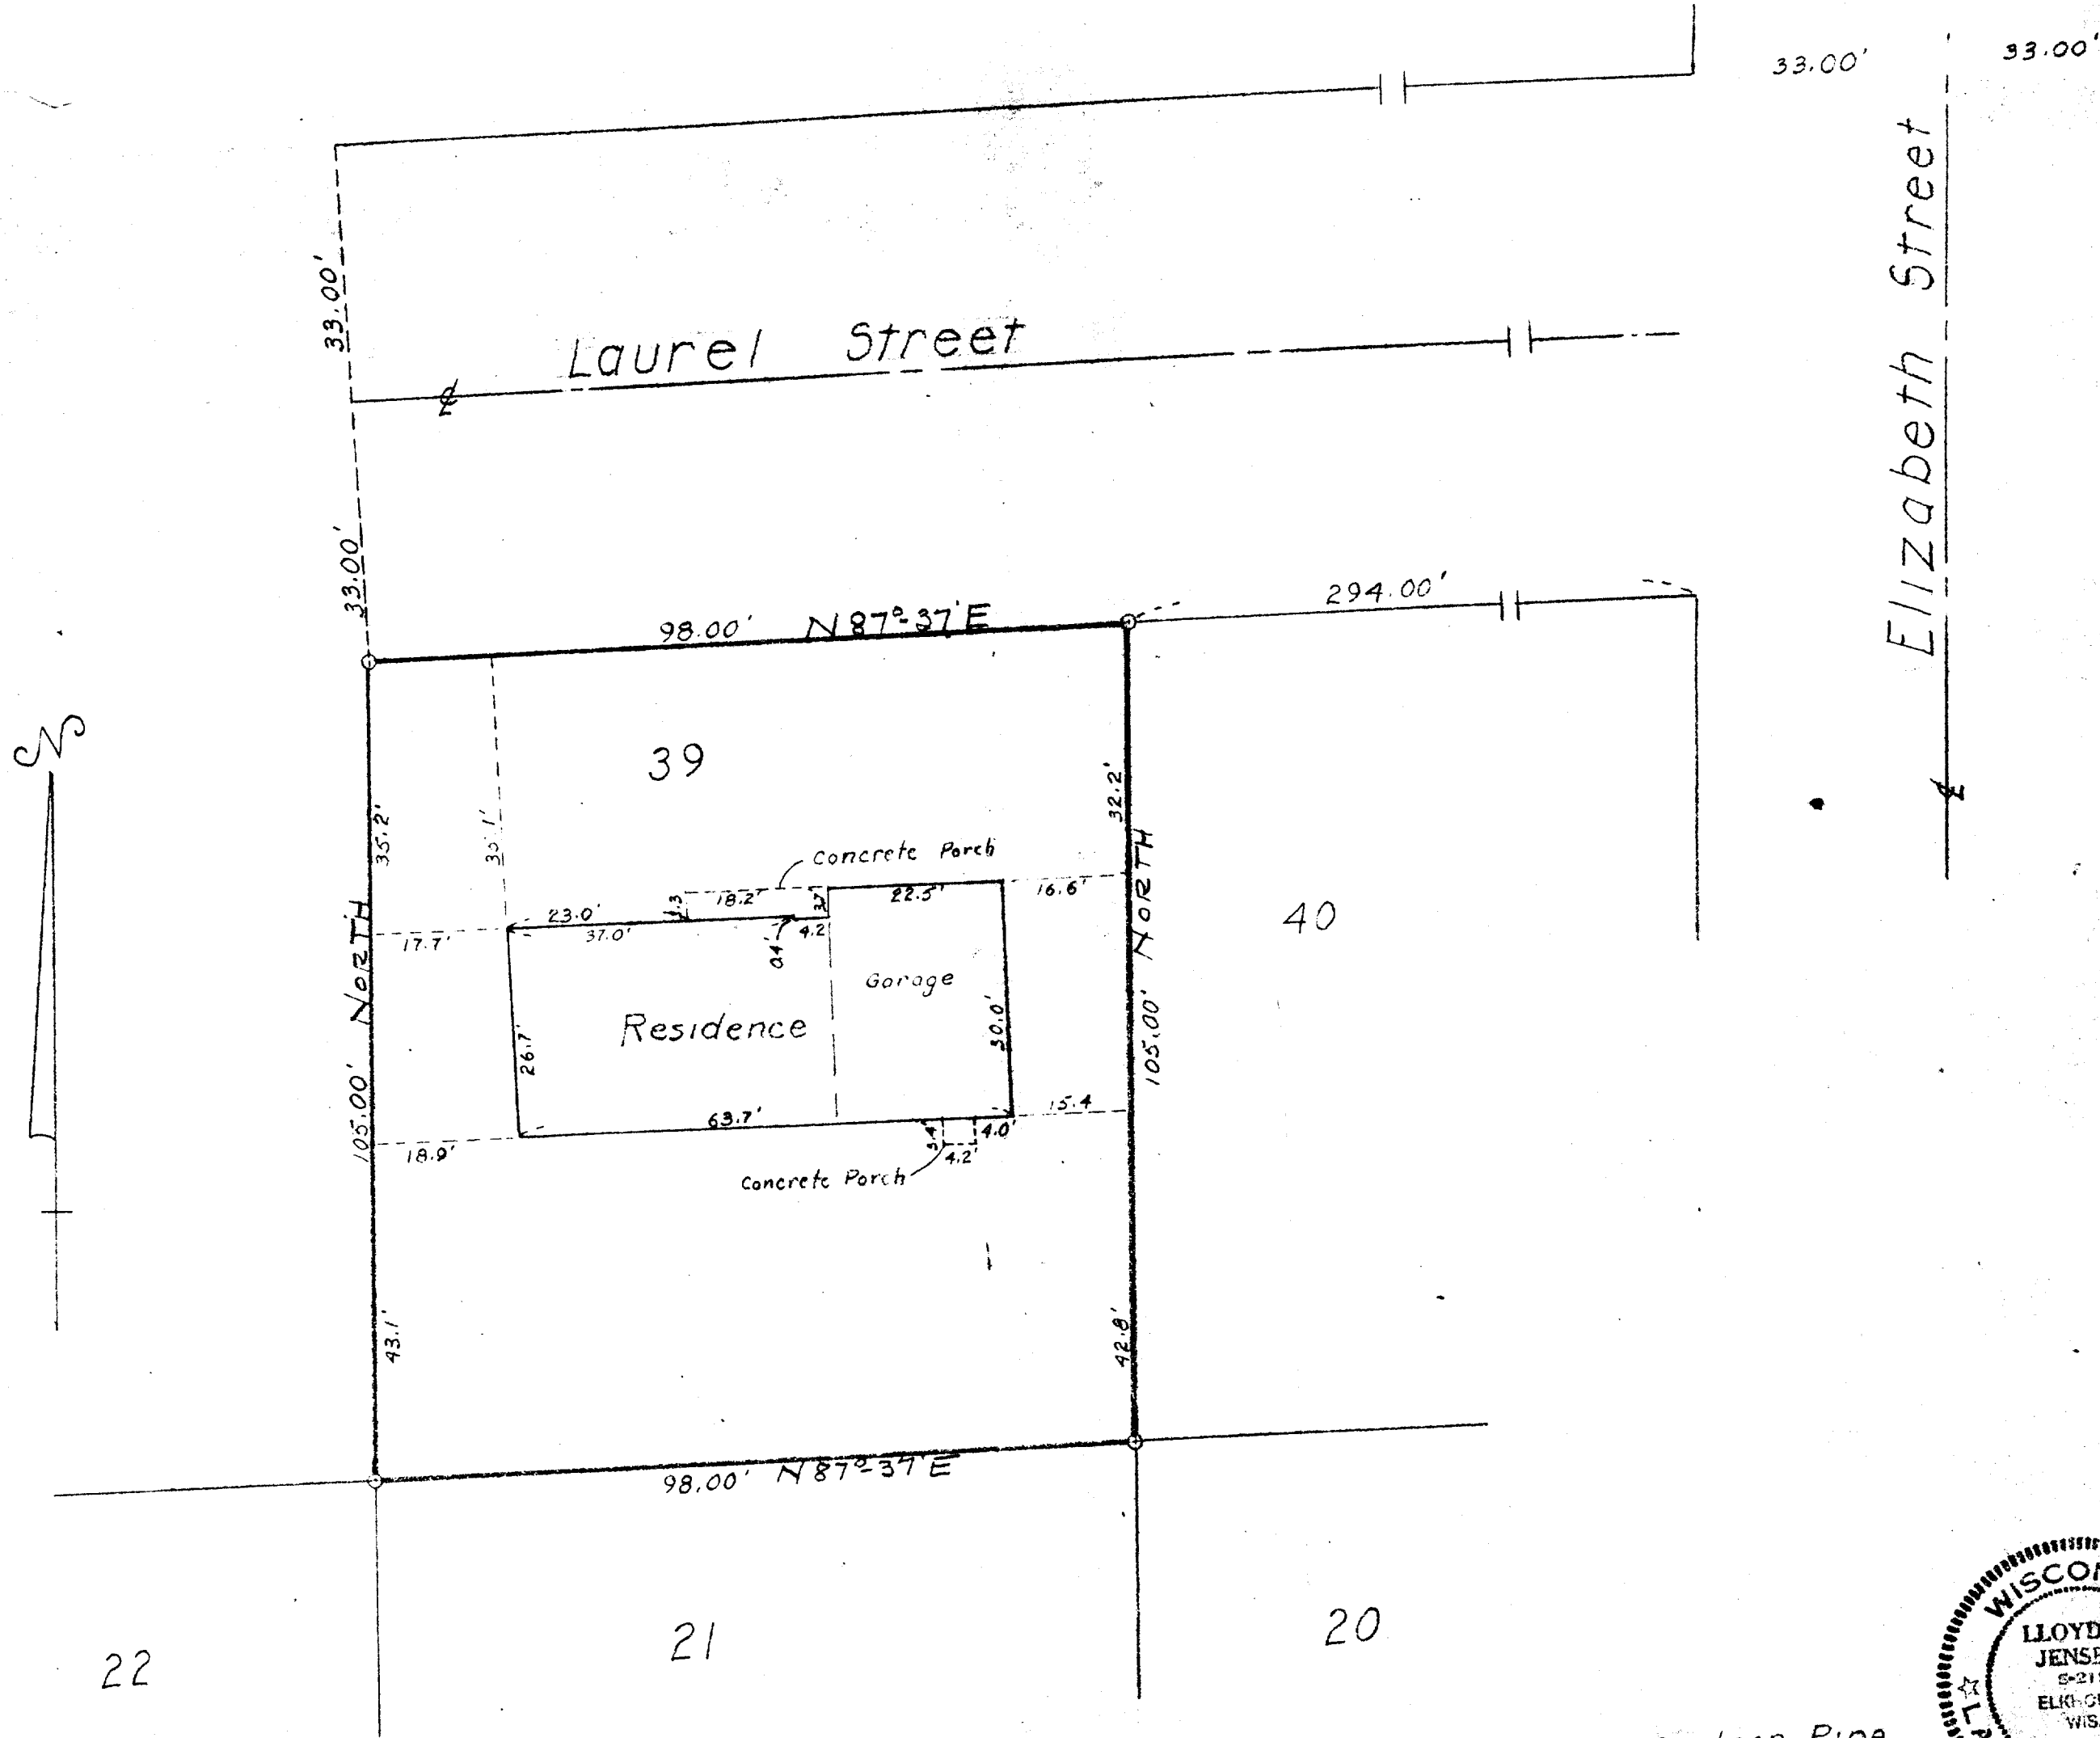

State of Wisconsin
County of Walworth

I, Lloyd L. Jensen, do hereby certify that I have surveyed the property hereon described according to the official records, and that the plat hereon is a correct representation of the lot lines and principal lines of the buildings thereon.

Lloyd L. Jensen
Surveyor

March 1957

PLAT OF SURVEY
OF

Lot 39 of Westpark Addition
City of Whitewater,
Walworth County, Wisconsin

Lloyd L. Jensen
Surveyor

SCALE 1" = 20'

10-93

DATE March 1957