


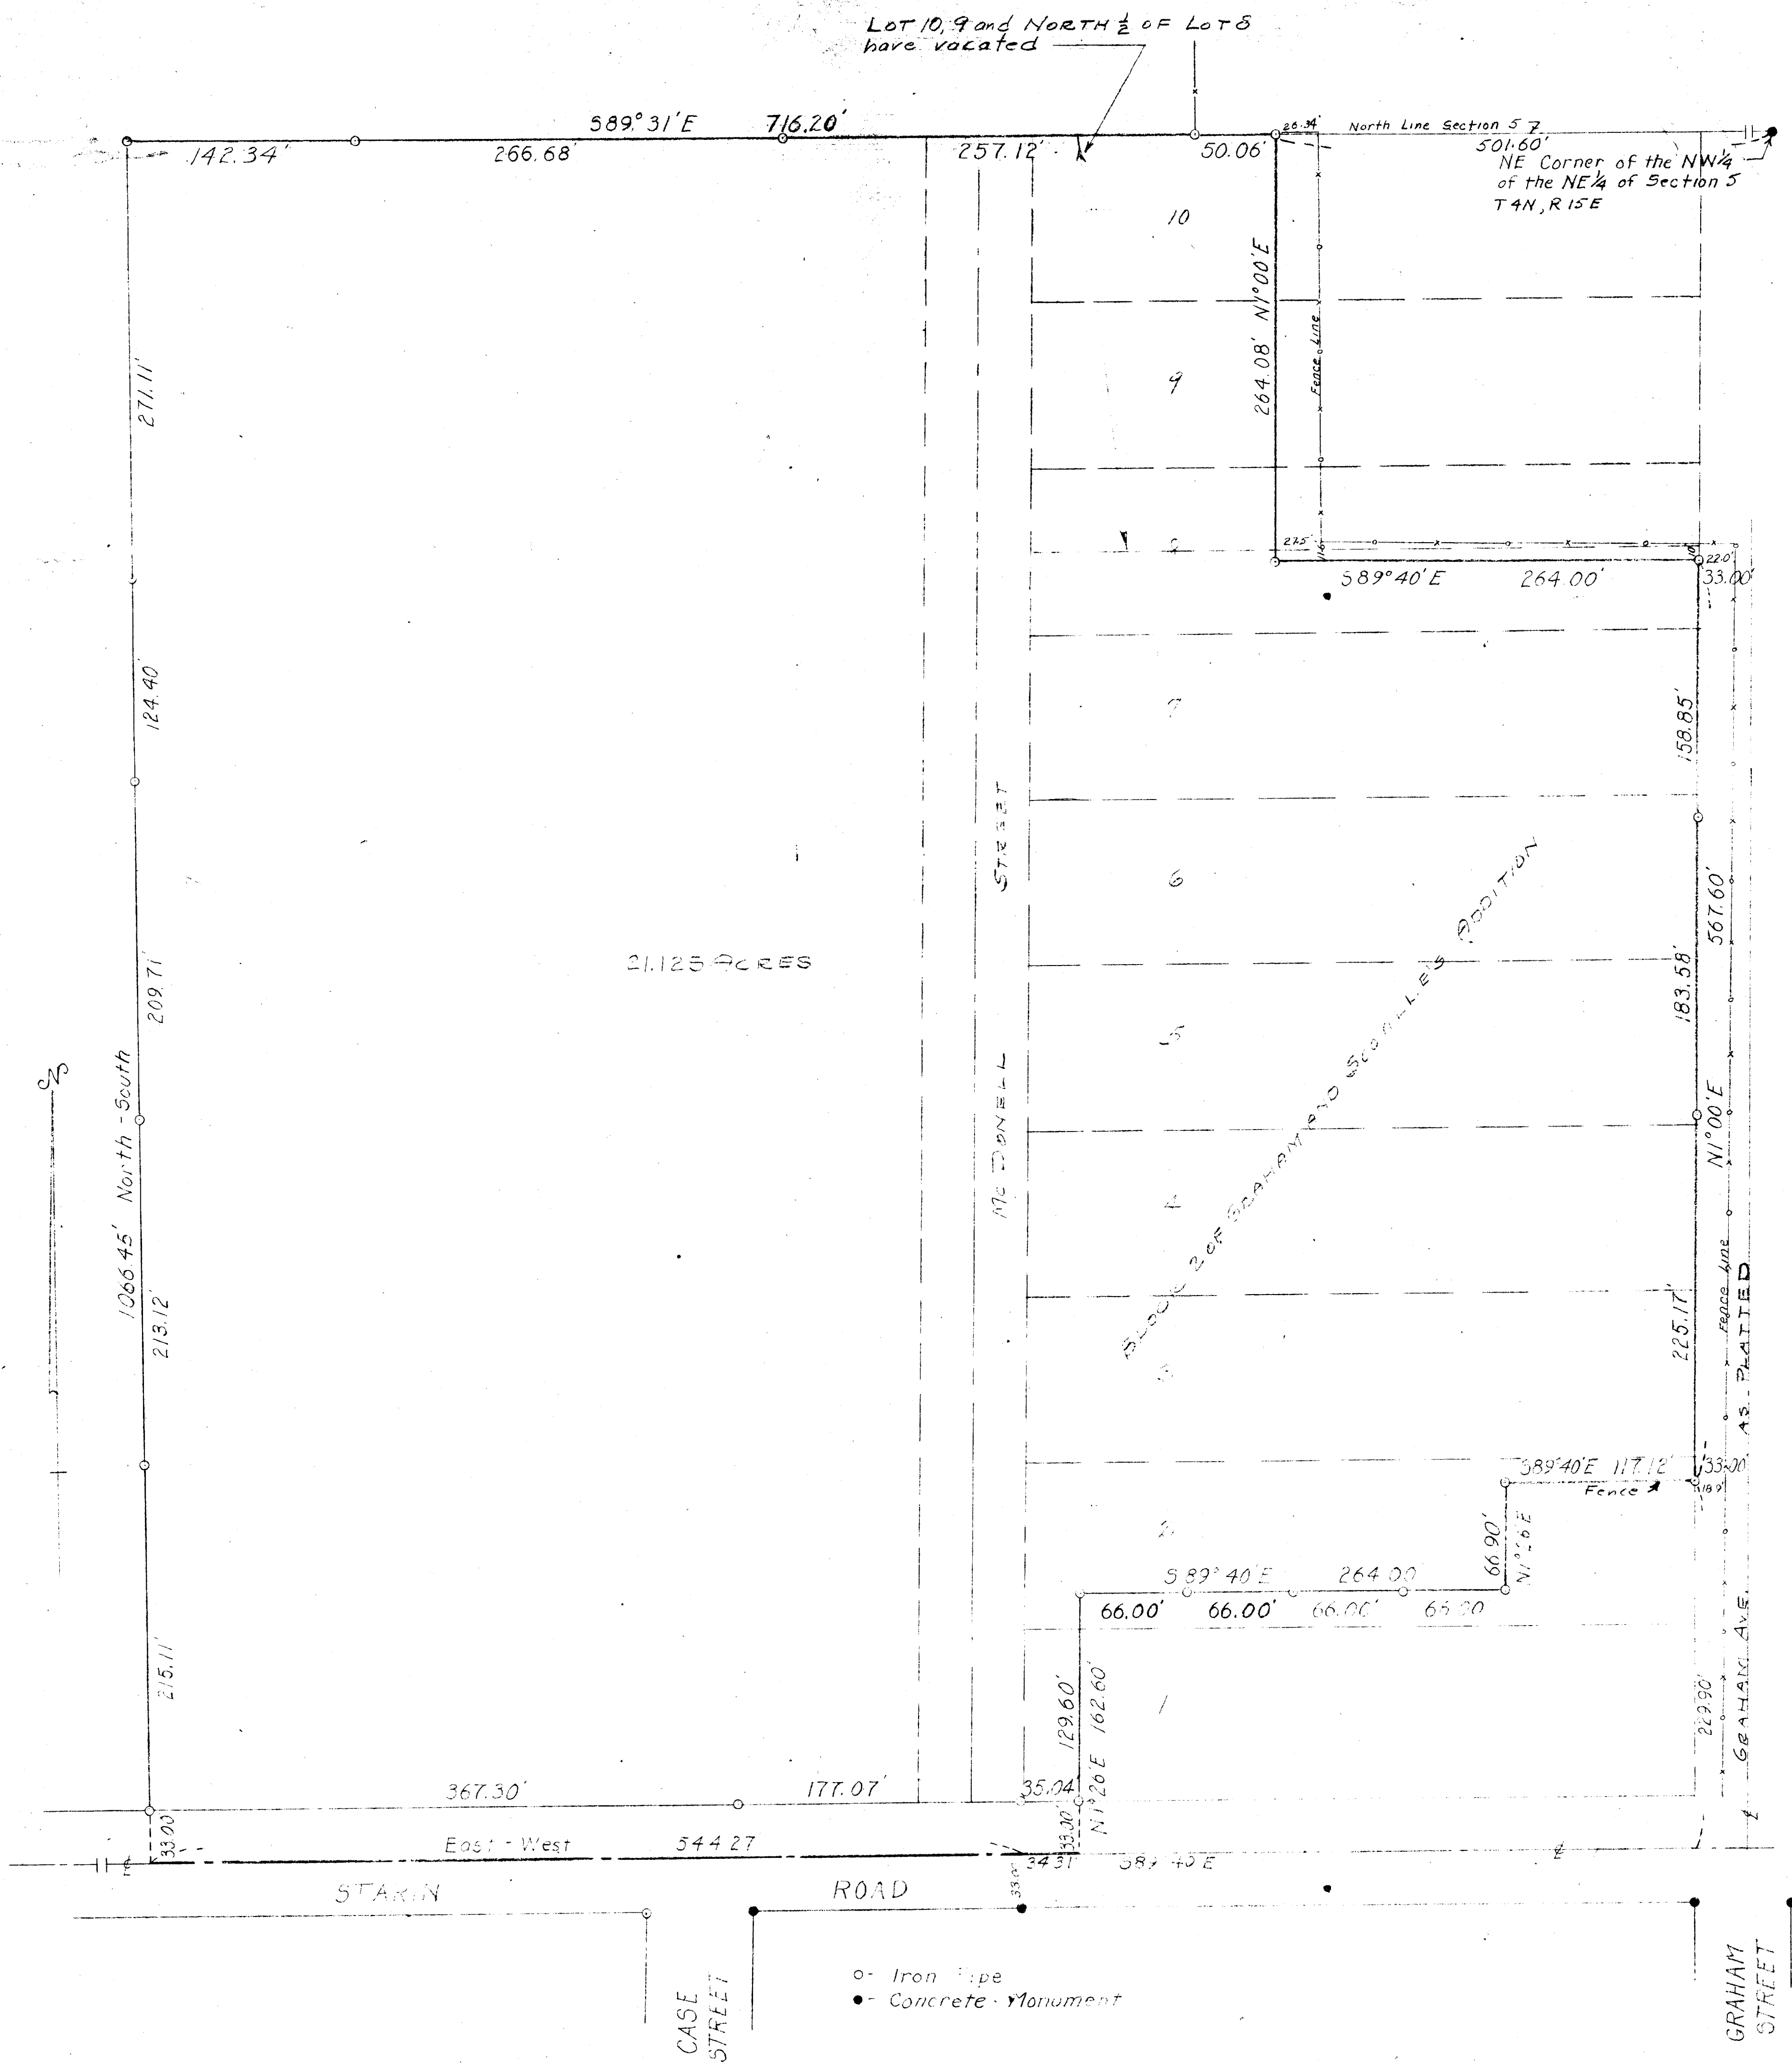

PLAT OF SURVEY OF

Parcel of land located in the NW $\frac{1}{4}$ of the NE $\frac{1}{4}$ of Section 5, T4N, R15E. City of Whitewater, Walworth County, Wisconsin

Lloyd L. Jensen
SURVEYOR

SCALE 1" = 50'

DATE March, 1957
May, 1962

10-85