
LAND-MARK SURVEYING Mark L. Miritz

Wisconsin Professional Land Surveyor S-2582


N9330 Knuteson Drive Whitewater, WI 53190 Phone:(262)495-3284 MARKMIRITZ@ LAND-MARKSURVEYING.COM

OWNERS: **DENISE P. EHREN** PATRICK DONAHOE 738 OHIO STREET **DARLINGTON, WI 53530**

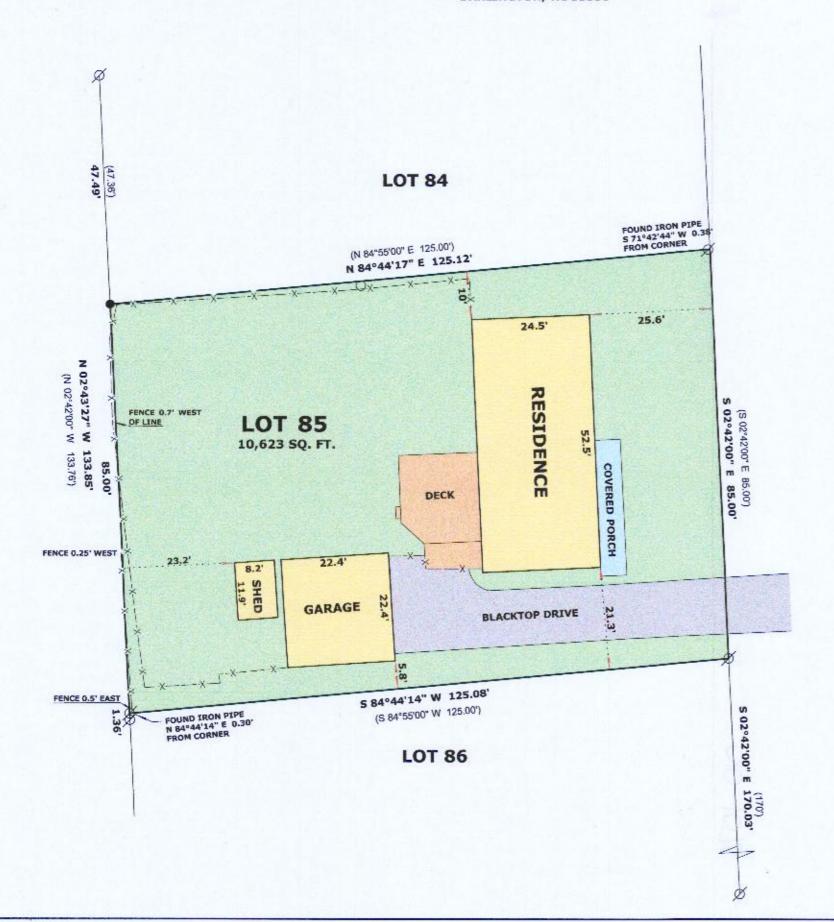

PLAT OF SURVEY

LOT 85, FIRST ADDITION TO BUCKINGHAM ESTATES, LOCATED IN THE SOUTHEAST 1/4 OF SECTION 6, TOWN 4 NORTH, RANGE 15 EAST, CITY OF WHITEWATER, WALWORTH COUNTY, WISCONSIN.

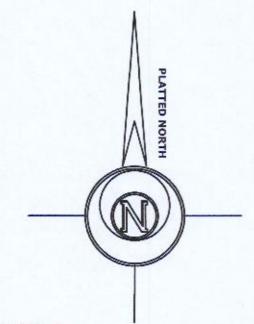



BUCKINGHAM

BLVD.

(70' WIDE)



LEGEND

FOUND IRON PIPE

SET IRON ROD, 18" LONG, WEIGHING 1.5 LBS./LINEAL FT., 3/4" DIA.

(xx)

Ø

RECORDED AS DIMENSION

EXISTING FENCE

SCALE: 1 INCH = 20 FEET

"I hereby certify that the above described property has been surveyed by me or under my direction and that the above map is a true representation thereof and shows the size and location of the property, its exterior boundaries, the location of all visible structures and dimensions of all principal buildings thereon, boundary fences, apparent easements, roadways and visible encroachments, if any."

"This survey is made for the use of the present owners of the property, and also those who purchase, mortgage, or guarantee the title thereto within one year from date hereof."

> MARK L. MIRITZ WISCONSIN PROFESSIONAL

LAND SURVEYOR S-2582

DATE:__ FEB. 20, 2020 JOB NO. 20.204

73UA-33