
## LAND-MARK SURVEYING Mark L. Miritz


Wisconsin Professional Land Surveyor S-2582

N9330 Knuteson Drive Whitewater, WI 53190 Phone:(262)949-1239 MARKMIRITZ@ LAND-MARKSURVEYING.COM

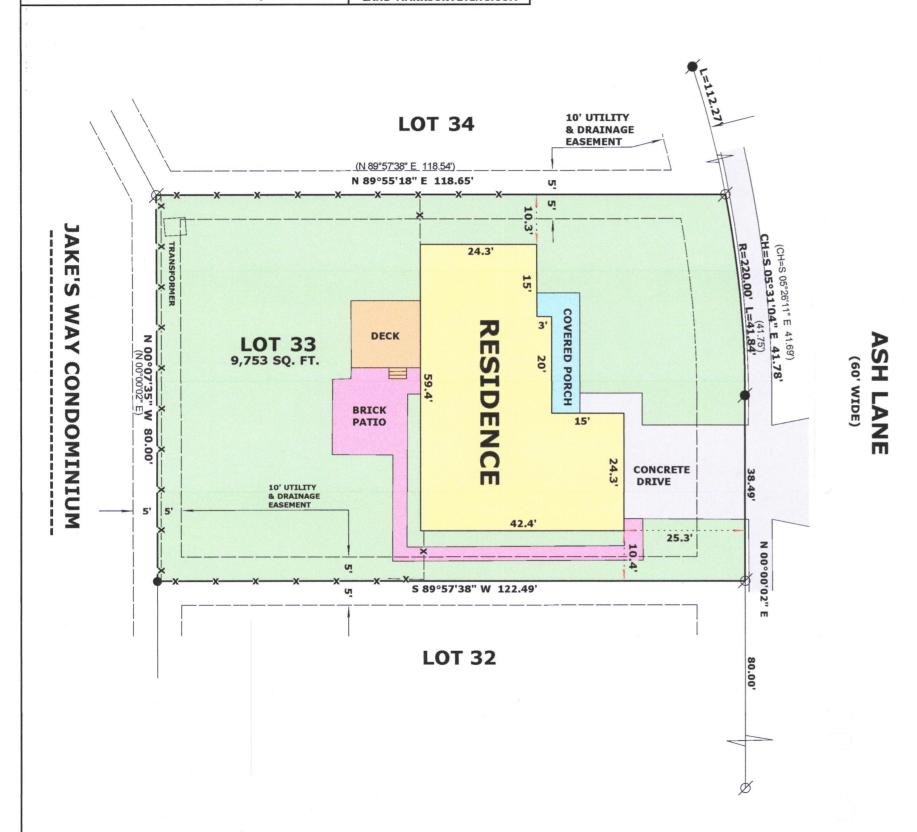

## PLAT OF SURVEY

LOT 33, WALTON'S PINE BLUFF SUBDIVISION, LOCATED IN THE SOUTHEAST 1/4, OF THE SOUTHEAST 1/4, SECTION 3, TOWNSHIP 4 NORTH, RANGE 15 EAST, IN THE CITY OF WHITEWATER, WALWORTH COUNTY, WISCONSIN

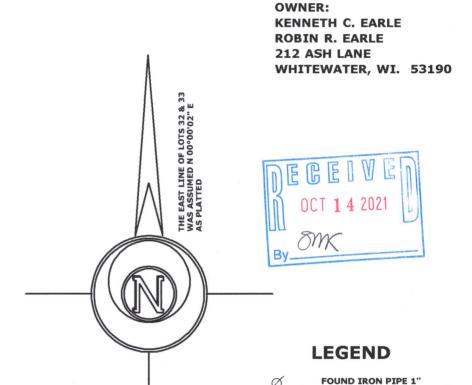

SCALE: 1 INCH = 20 FEET

RECORDED AS DIMENSION

**EXISTING WOOD FENCE** 

FOUND IRON PIPE 2"

SET IRON ROD, 18" LONG, WEIGHING 1.5 LBS./LINEAL FT., 3/4" DIA.

"I hereby certify that the above described property has been surveyed by me or under my direction and that the above map is a true representation thereof and shows the size and location of the property, its exterior boundaries, the location of all visible structures and dimensions of all principal buildings thereon, boundary fences, apparent easements, roadways and visible encroachments, if any."

"This survey is made for the use of the present owners of the property, and also those who purchase, mortgage, or guarantee the title thereto within one year from date hereof."

MARK L. MIRITZ
WISCONSIN PROFESSIONAL
LAND SURVEYOR S-2582

DATE: OCT. 26, 2021

JOB NO. 16.204

MARKL

MIRITZ

S-2582 WHITEWATER,