

DESCRIPTION

Lot 1, Block 31, CHAPMAN & LUDINGTON in Section 5, T4N, R15E, City of Whitewater, Walworth County, Wisconsin.

CERTIFICATION


I certify that the property described above has been inspected under my responsible direction and supervision and that the above map is a correct representation of the size and location of the property, its exterior boundaries, the location and dimensions of all visible structures thereon, apparent easements and roadways, and visible encroachments, if any.

This inspection is made for the exclusive use of the present owners of the property, and also those who purchase, mortgage, or guarantee the title thereto within one year from date hereto; and as to them I certify the accuracy of said map.

Date 1-25-78

Mark E. Anderson
Mark Anderson
Registered Land Surveyor, S-1370

For: Banco Mortgage Company
131 West Wilson
Madison, WI 53703

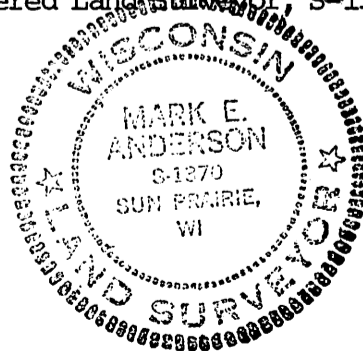

78S-13