


623315

TIR'S OFFICE 15
Dith Co., Wis. 1 S
for record this 22nd
Jul 1970 A.D. at 8:00
A, and Recorded in Vol.
of Sec. on page 35
Kuchow, Register of Deeds

A.P. 28 Deputy A. S. M. D.

CERTIFIED SURVEY NO. 35

HAROLD H. KOLB
REGISTERED PROFESSIONAL LAND SURVEYOR
TWIST BUILDING
LAKE GENEVA, WIS. 53147

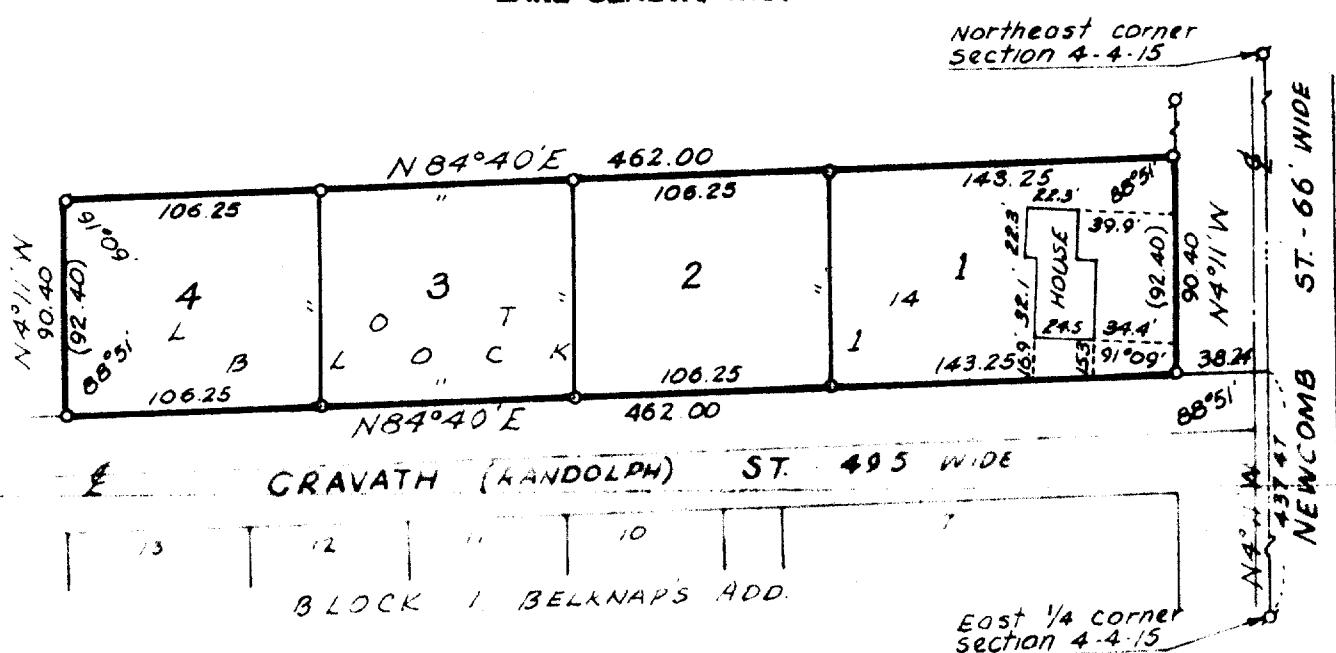

CERTIFIED SURVEY OF
a parcel of land located in the Northeast 1/4 of Section 4, T 4 N, R 1 E, City of Whitewater, Walworth County, Wisconsin and described as lot 14, block 1, Belknap's Addition, and more particularly described as follows: Commencing at the East 1/4 corner of said section 4; thence N 4°11' N 437.47 feet; thence S 84°40' W 38.04 feet to the place of beginning; thence continue S 84°40' W 461.00 feet; thence N 4°11' W 90.40 feet; thence S 84°40' W 461.00 feet; thence S 4°11' E 90.40 feet to the place of beginning.

I, Harold H. Kolb, do hereby certify that I have surveyed the property herein described according to the official records, and that the plat herein is a correct representation of the lot lines, and that I have fully complied with Chapter 736, 34 of the Wisconsin Statutes.

Harold H. Kolb
Harold H. Kolb
Wisconsin Surveyor, #137
Whitewater, April 23, 1970

N



SCALE: 1"=80'

LEGEND

- () Iron pipe found
- () Iron pipe placed, 1" x 24", min. wt. 1.13 lb./lin. ft.
- () As platted

OWNER: Geraldine Guilliam
NOTE: Bearings are true by solar observation.



Ent. No. 35

10-123