


HAROLD H. KOLB
 REGISTERED PROFESSIONAL LAND SURVEYOR
 LAKE GENEVA, WISCONSIN

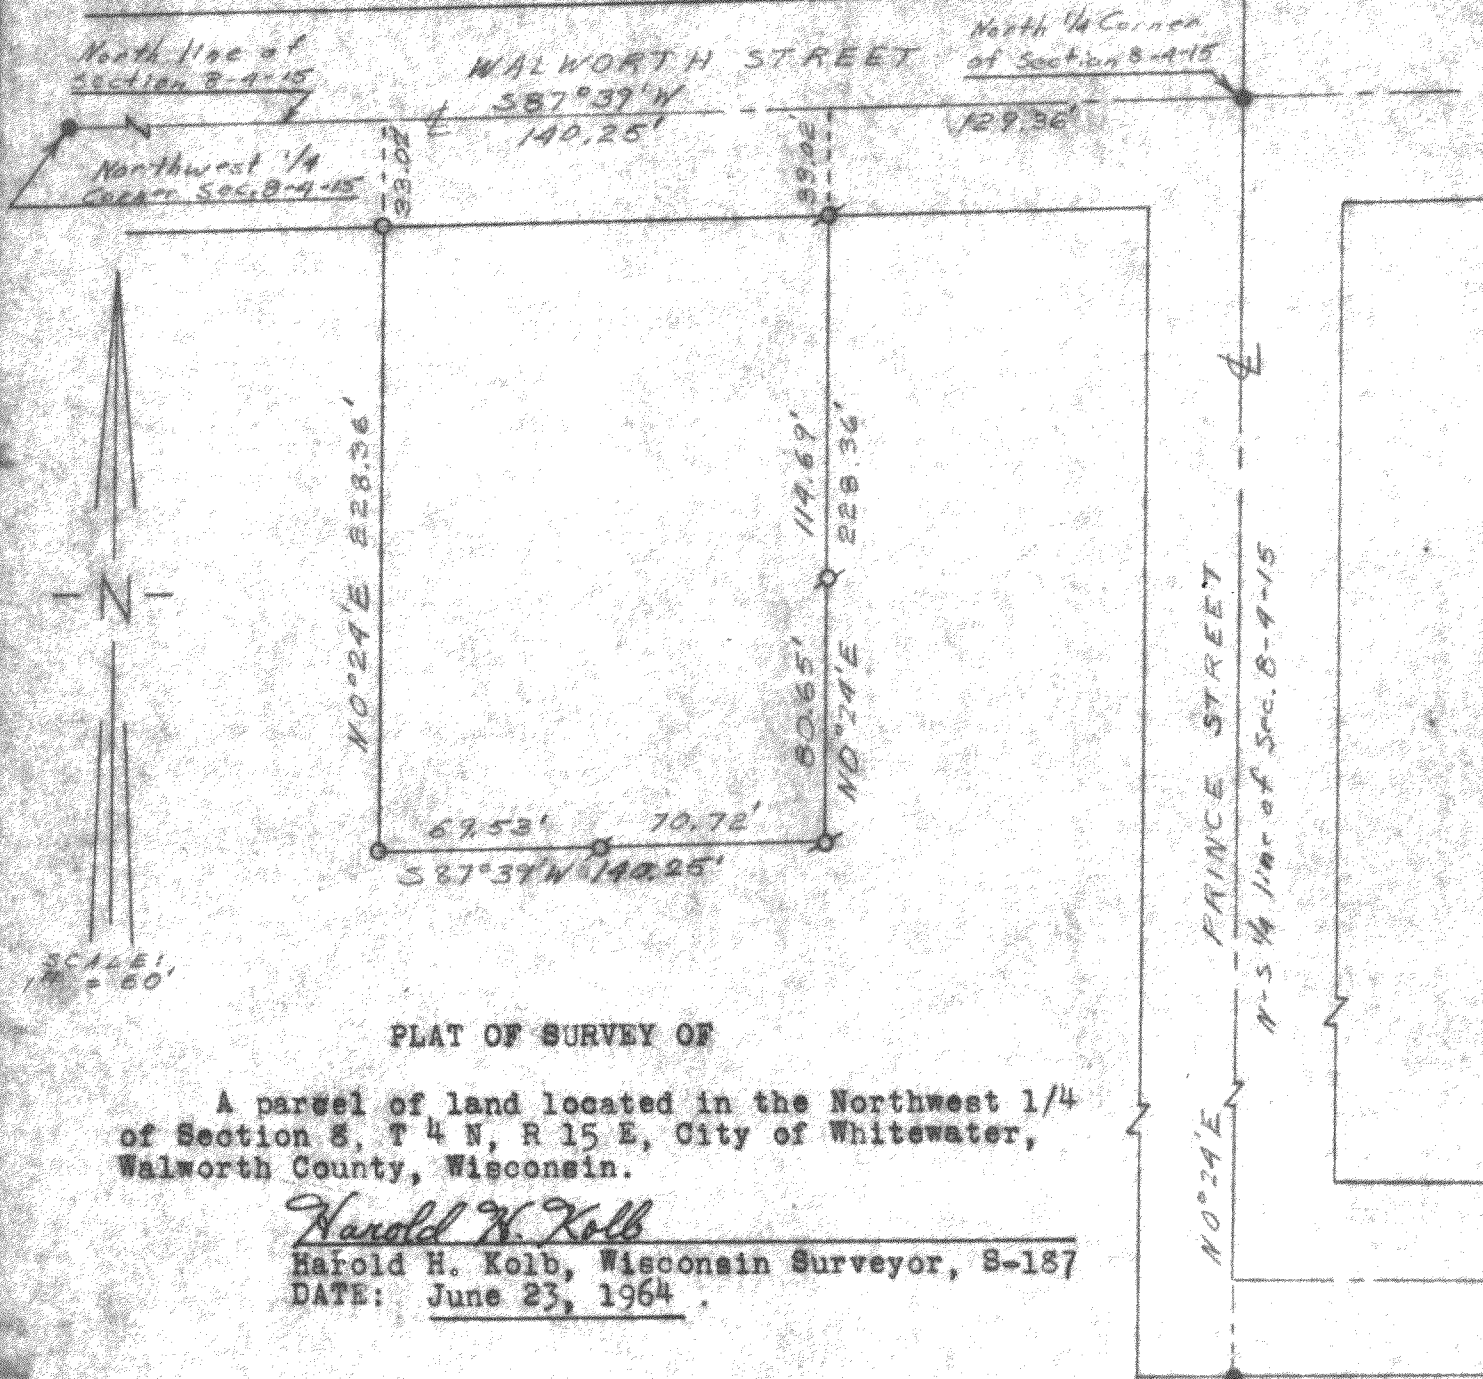

- Concrete Monument Found
- Iron Pipe Found
- Iron Pipe Placed

UP-313

10-149

10-28A