



- IRON PIPE FOUND
- IRON PIPE SET

WALWORTH STREET

5/4 CORNER SECTION 5-4-15

NORTH 660'

PRINCE STREET (66 FEET WIDE)

SOUTH 66.00' (4 RODS)

N 87°50'E 297.00' (18 RODS)

297.00'

WUP-208 VOL. 474-P. 435

S 87°50'W 297.00' (18 RODS)

SOUTH 594.0' (36 RODS)

NORTH 66.00' (4 RODS)

33.0'

3.6'

3.0'

RES

GAP

66.00'

92°10'

92°10'


DESCRIPTION:

COMMENCING AT A POINT IN THE WEST LINE OF PRINCE ST. 594.00 FEET SOUTH OF THE NORTH LINE OF THE SE 1/4 OF THE SW 1/4 OF SECTION 5, T4N, R15E, WALWORTH COUNTY WISCONSIN, SAID POINT BEING THE PLACE OF BEGINNING OF THE LANDS HEREINAFTER DESCRIBED TO-WIT; THENCE S 87°50'W 297.00 FEET, THENCE SOUTH 66.00 FEET, THENCE N 87°50'E 297.00 FEET TO A POINT IN THE WEST LINE OF PRINCE ST. THENCE NORTH ALONG SAID WEST STREET LINE 66.00 FEET TO THE PLACE OF BEGINNING, CONTAINING 19,588 SQ. FT.

NORTH LINE OF THE SE 1/4 OF THE SW 1/4 OF SECTION 5, T4N, R15E

CERTIFICATE:

I, JOSEPH M. BIAGI, SURVEYOR, DO HEREBY CERTIFY THAT I HAVE SURVEYED THE PROPERTY HEREON DESCRIBED. SEPT. 12, 1974

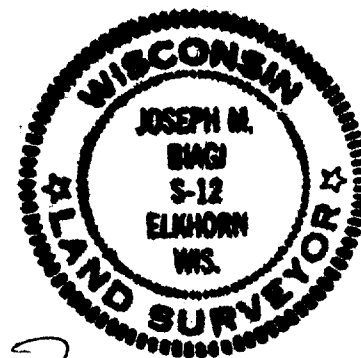

Joseph M. Biagi
 JOSEPH M. BIAGI RLS 12
 ELKHORN, WISCONSIN

| REVISIONS | | | SURVEY FOR | | |
|-----------|------|----|--|----------|-------------|
| NO. | DATE | BY | MRS. ROY JAHNKE | | |
| 1 | | | PART OF THE SE 1/4 SW 1/4 OF SECTION 5, T. 4 N, R. 15 E. | | |
| 2 | | | | | |
| 3 | | | DRAWN BY | SCALE | MATERIAL |
| 4 | | | HWG | 1" = 50' | |
| 5 | | | CHK'D | DATE | DRAWING NO. |
| | | | TRACED | 7-10-74 | # 99-74 |