


#53/71

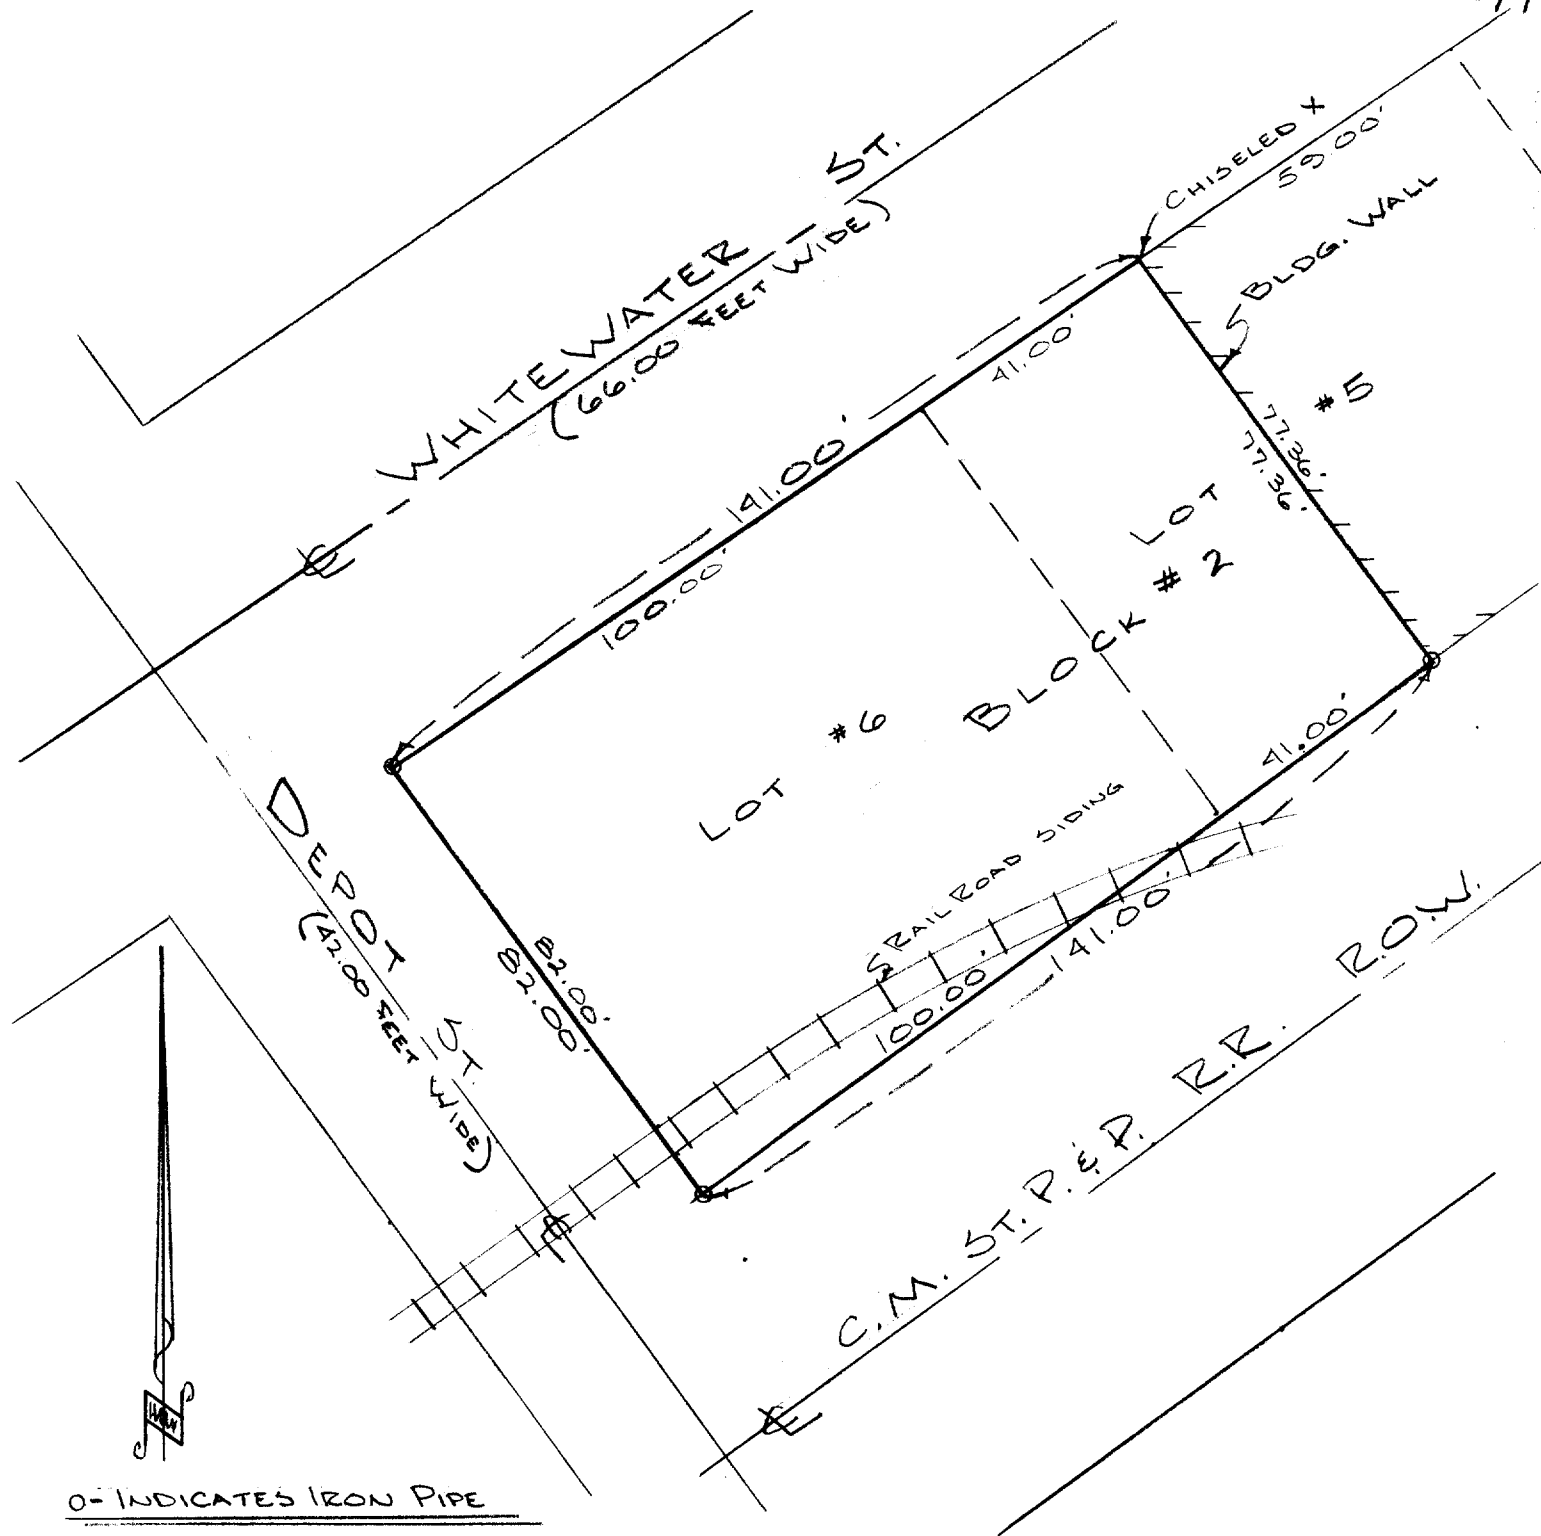

DESCRIPTION:

Lot 6 and Lot 5 excepting the east 59.0 feet thereof of Block 2, in Tripp's Addition to the City of Whitewater, Walworth County, Wisconsin.

CERTIFICATE:

I, James F. Biagi, Surveyor, do hereby certify that I have surveyed the property herein described.

JAMES F.

BIAGI

MILWAUKEE, WIS.

James F. Biagi, RLS 272
Milwaukee, Wisconsin.

March 30th 1971.