


o Indicates Iron Pipe Found
o Indicates Iron Pipe Set
Scale 1"=30'

DESCRIPTION: The N'y 15 feet of the following described parcel; Commencing 120 feet South of the NE corner of Block 6 of Conger's Sub. of Block 6 of Birge's Addition to the City of Whitewater, Walworth County, Wisconsin; Thence West 99 feet; Thence North 20 feet; Thence West to the East line of Lot 1 said Block 6; Thence South to point 10 rods South of NE corner of said Lot 1; Thence East to East line of said Block 6; Thence North to place of beginning.

CERTIFICATE: I, Alan L Berg, a registered surveyor of the State of Wisconsin, do hereby certify that on April 15, 1974, I surveyed the above described property according to the official records and that the accompanying plat is a correctly dimensioned representation to the scale of the boundaries.

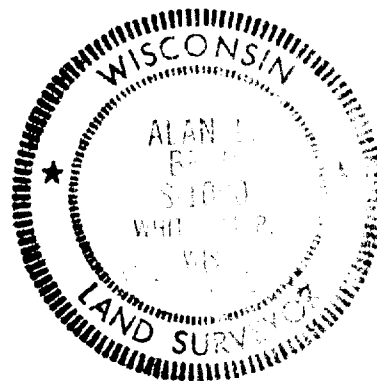

10-233