


FARRIS, HANSEN & COOPER, INC.

ENGINEERING, SURVEYING AND LAND PLANNING
715 W. WALWORTH ST. - P.O. BOX 487 - ELKHORN, WI 53121
OFFICE: 414/723-2088

MORTGAGE INSPECTION SURVEY

NOTE: THIS IS NOT A 'PROPERTY SURVEY' AS DEFINED IN SEC. 5.01 OF THE WIS. ADMIN. CODE.

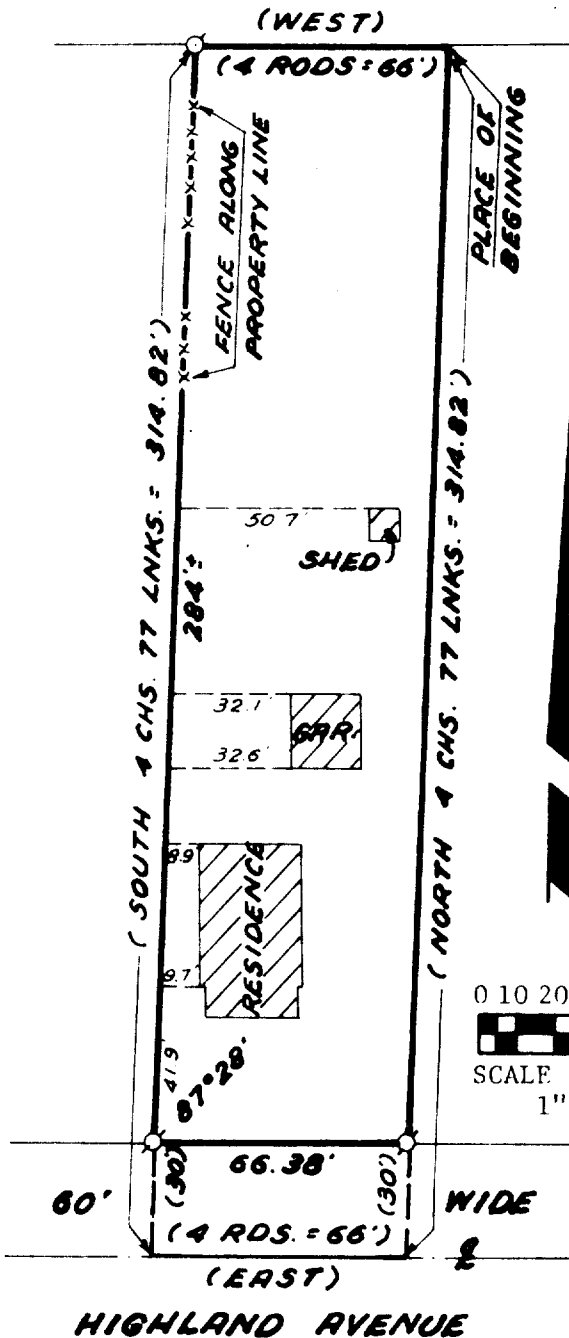

DESCRIPTION: A part of the NE 1/4 of the SW 1/4 of Section 5, T 4 N, R 15 E, and bounded as follows: Commencing in the Northwest corner of lands conveyed to C. P. Kroft and wife to William L. Schultz by deed dated March 5, 1926, and recorded March 12, 1926 at 9 o'clock P.M., in Volume 16 of Deeds at page 379 which corner is 44 rods West of the center of Prince Street and is 29 rods and 29 1/2 Links South of the East and West quarter line of said Section 5, and thence thence West on a continuation of the North line of the land owned by one George Demko, and on the South line of lands conveyed by E. W. Pratt to C. County and owned by Bill Harris, 4 rods; thence South parallel to the West line of lands owned by said William Schultz as described in the deed recorded in Volume 16 of Deeds at page 379, 4 chains and 27 Links to Highland Street; thence East 4 rods to the Southwest corner of lands now owned by William Schultz and described in the aforesaid deed recorded in Volume 16 of Deeds at page 379; thence North along the West line of said Schultz land 4 chains and 27 Links to the Place of Beginning, Intending to describe a strip of land 4 rods in width directly West of and adjoining the lands described in Volume 16 of Deeds at page 379, which strip is of equal width throughout its entire course.

ORDERED BY:

Waukesha Savings and Loan Association
Attn: Dennis DeBartolo

SELLERS: Roy & Deborah Rockwell

BUYERS: Morwin S. Margery Watson

PROPERTY: 1117 Highland Street

LOCATION: Whitewater, WI

I HEREBY CERTIFY that this map is a true and accurate representation of the lot lines as found to be monumented and the location of the buildings located thereon to the best of my knowledge and belief.


Daniel D. Cooper
Daniel D. Cooper, PLS No. 1464

9/20/2011
Date

LEGEND

⊗ - Iron Pipe Found

() - Record Measurement

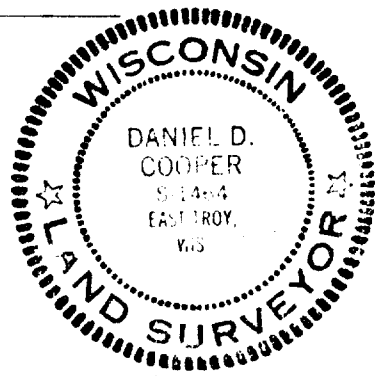

DRAWING NUMBER 1475

UP-194A

10-265F