HOME OFFICE BURLINGTON, WISCONSIN 53105 PHONE: 414-763-2652 414-763-7834

ROBERS & BOYD, INC.

CONSULTING ENGINEERS LAND SURVEYORS


BRANCH OFFICE 809 - 43RD STREET KENOSHA, WISCONSIN 53140 PHONE: 414-658-4488

MORTGAGE INSPECTION FOR UNIVERSAL MORTGAGE OF

Lot 19, Block 4, Wilson's Addition to the City of Whitewater, Walworth County, Wisconsin.

Michael & Denise Sizemore

365 Jefferson Street Whitewater, WI

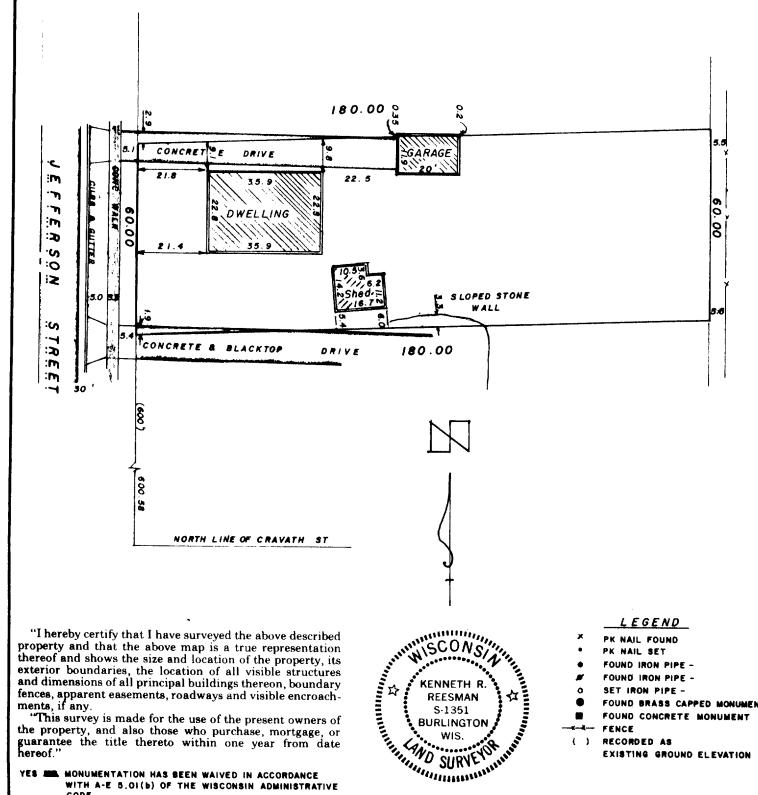

"I hereby certify that I have surveyed the above described property and that the above map is a true representation thereof and shows the size and location of the property, its exterior boundaries, the location of all visible structures and dimensions of all principal buildings thereon, boundary fences, apparent easements, roadways and visible encroach-

"This survey is made for the use of the present owners of the property, and also those who purchase, mortgage, or guarantee the title thereto within one year from date hereof."

YES AND MONUMENTATION HAS BEEN WAIVED IN ACCORDANCE WITH A-E 5.01(b) OF THE WISCONSIN ADMINISTRATIVE CODE.

WISCONSIN REGISTERED LAND SURVEYOR

9-4-81 DATE

DRAWN BY KRR FIELD WORK BY KRR GJA

81146 JOB NUMBER

FOUND BRASS CAPPED MONUMENT FOUND CONCRETE MONUMENT

EXISTING GROUND ELEVATION

\$CALE-1" =30'

PK NAIL FOUND

PK NAIL SET FOUND IRON PIPE -FOUND IRON PIPE -SET IRON PIPE -

FENCE RECORDED AS