

FARRIS, HANSEN & COOPER, INC.

ENGINEERING, SURVEYING AND LAND PLANNING

715 W. WALWORTH ST. - P.O. BOX 487 - ELKHORN, WI 53121

OFFICE: 414/723-2098

MORTGAGE

INSPECTION

Lot 4, Block 31, Chapman and
Ludington's Addition to the
City of Whitewater, Walworth
County, Wisconsin.

OWNER: Lyle Blaedow
343 S. Janesville St
Whitewater, WI

BUYER: James
Williams

NOTE: THIS
IS NOT A "PROPERTY
SURVEY" AS DEFINED IN
SEC. A-E 5.01 OF
THE WISCONSIN AD-
MINISTRATIVE CODE.

LEGEND

- Iron Pipe Found
- Iron Bar Found
- ⊙—Iron Rod Found
- Concrete Mounument Found
- ()—Record Dimension

DETAIL
SCALE: 1"=30'


BLOCK

RESIDENCE

LOT 4

GARAGE

MEADOW ALLEY

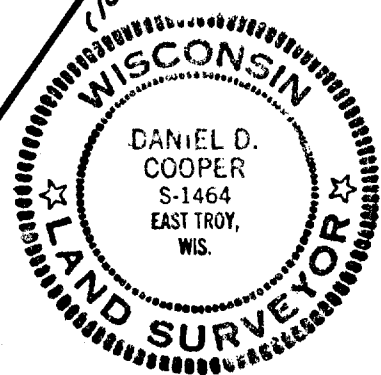

ORDERED BY: Waukesha Savings
and Loan Association--Mrs.
Gail L. Albrecht

I hereby certify that this
map is a true and accurate
representation of the lot
lines and the location of
the buildings thereon to the
best of my knowledge and
belief.

Daniel D. Cooper
Daniel D. Cooper S-1464
Wis. Registered Surveyor
Oct 22, 1978
Date

DRAWING NUMBER 1416

10-3164