

PLAT OF SURVEY

extra copy

66'
ST.

FLORENCE STREET

PRINCE

STREET

CASE

CENTER

MAIN

ST.

E 1/4 CORNER

SEC. 5-4-15

N88°52'20"W
2184.03

SEC. 5-4-15

N88°52'20"W 200.84'

S2°47'10"W
90.05'

66.00'

S88°52'20"E

PARCEL "A"

56,203 SQ. FT.

SHED

APARTMENT BUILDING

282.84'

S2°47'10"W

372.94'

N2°47'10"E


60'

134.84'

S88°51'00"E


356.03'

N2°47'10"E

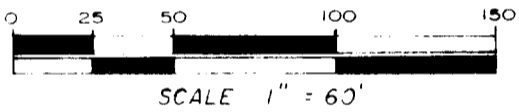

- Section corner set from ties
- Found 2" iron pipe
- ⊙ Found 1" iron pipe in a 2" iron pipe
- Found 1-1/4" iron pipe
- ⊙ Found 1" iron pipe
- Found 3/4" iron pipe

University of Wisconsin-Whitewater
Attn: Dr. Dale Brock
Whitewater
Wisconsin 53190

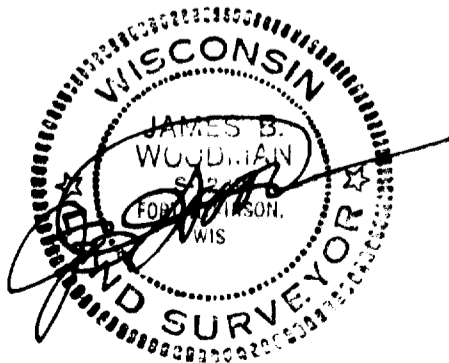

Sheet 1 of 2

2-28-83

JN 83S-10

STRAND & WOODMAN ASSOCIATES
210 Madison Ave., Fort Atkinson, WI 53538

Land Surveyors & Engineers
Phone (414) 563-8162

WUP-144

10-3248

PLAT OF SURVEY

DESCRIPTION

Parcel "A"


A part of the SW $\frac{1}{4}$ of the NE $\frac{1}{4}$ of Section 5, T4N, R15E, City of Whitewater, Walworth County, Wisconsin, to-wit:

Commencing at the E $\frac{1}{4}$ corner of said Section 5; thence N88°52'20"W, along the south line of said NE $\frac{1}{4}$, 2184.03 feet; thence N02°47'10"E, along the west line of Case Street and its extension, 356.03 feet to a 2" iron pipe and the point of beginning; thence continue N02°47'10"E, along said west line, 372.94 feet to a 1" iron pipe; thence N88°52'20"W, along the south line of Florence Street, 200.84 feet to a 2" iron pipe; thence S02°47'10"W, 90.05 feet to a 2" iron pipe; thence S88°52'20"E, 66.00 feet to a 2" iron pipe; thence S02°47'10"W, 282.84 feet to a 2" iron pipe; thence S88°51'00"E, 154.84 feet to the point of beginning, containing 56,203 square feet.

CERTIFICATION

I hereby certify that the property described above has been surveyed under my responsible direction and supervision and that this map is a correct representation of the lot lines and dimensions and the principle lines of the permanent structures thereon.

Date 2-28-83

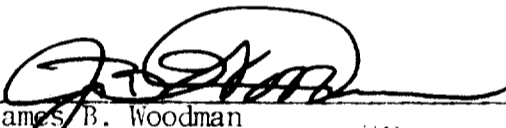
James B. Woodman
Registered Land Surveyor
