


- LEGEND**
- ▲ FIRE HYDRANT
 - ⊙ SANITARY MANHOLE
 - T/C TOP OF CURB
 - △ SURVEY CONTROL POINT



- NOTES**
1. This map was prepared by the undersigned on or about the date hereinafter stated, and is a true and correct representation of the facts as shown on the ground.
 2. The project benchmark is located at the intersection of Ann and Depot Streets as shown, elevation 817.52 feet U.S.M.S. (N.O.A.A.) datum.
 3. Project benchmark is top stem of hydrant located at the intersection of Ann and Depot Streets as shown, elevation 817.52 feet U.S.M.S. (N.O.A.A.) datum.
 4. Property lines shown are approximate only, and do not originate from an accurate field survey.

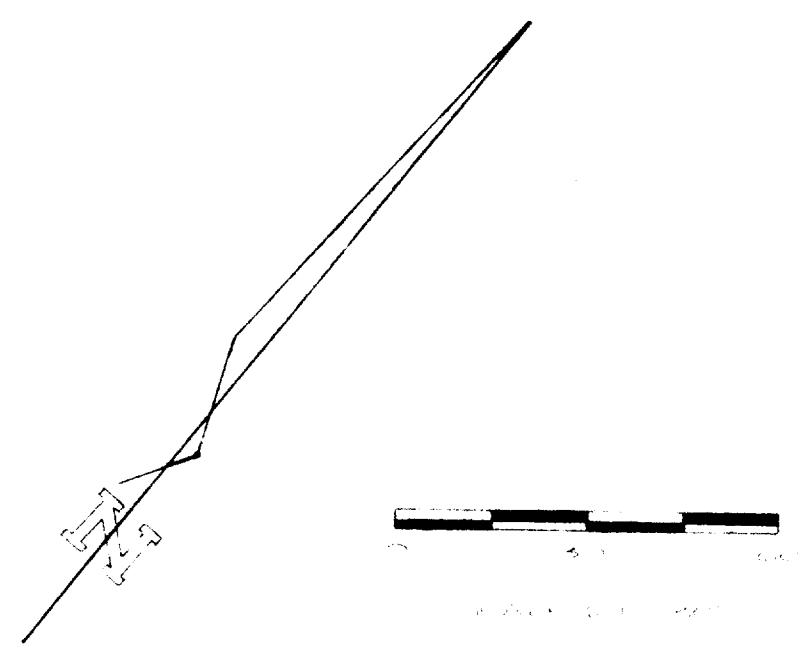

SURVEYOR'S CERTIFICATE

I, Glen L. Northrop, Registered Land Surveyor, do hereby certify that this map was prepared under my direction and control and is a true representation of the field survey made.

Dated this 20 day of NOVEMBER, 1981, at Cambridge, Wisconsin.

Glen L. Northrop
 Glen L. Northrop S-982

FLOOD PLAN MAP	
PART OF THE SW ⁴ OF THE SW ⁴ OF SECTION 4, T. 4 N., R. 15 E., ALSO LOT 1 AND THE E ¹ / ₂ OF LOT 2, BLOCK 5, TRIPPS ADDITION TO THE CITY OF WHITWATER, WALWORTH COUNTY, WISCONSIN.	
Surveyed by: ABEX Survey Ltd. Box 369, Cambridge, WI	
Surveyed for: Mr. Neil Stone 147 Newcomb Street, Whitewater, WI	
Surveyed: Oct 19, Nov 9, 1981; D. Riesop, G. Northrop	Order No. AB 828-81
Drawn: Nov 10, 1981; D. Riesop	Dwg. No. 828
Printed:	Sheet 1 of 1