

0 SET 1 1/4" x 24" IRON PIPE

NOTE: This parcel is being created for a sale of land between adjacent owners.



WHITEWATER ST. (66)

DESCRIPTION

A part of Lot 3, Block 28, CHAPMAN & LUDINGTONS ADDITION in the SE 1/4, Section 5, T4N, R15E, City of Whitewater, Walworth County, Wisconsin, to-wit:

Beginning at a 1 1/4" iron pipe at the SW Corner of said Lot 3; thence N0°10'00"W, along the west line of said Lot 3, 64.14 feet to a 1 1/4" iron pipe at the NW Corner of said Lot 3; thence N89°47'40"E, along the north line of said Lot 3, 28.60 feet to a 1 1/4" iron pipe; thence S0°21'40"W, 64.14 feet to a 1 1/4" iron pipe on the south line of said Lot 3; thence S89°47'40"W, along said south line, 28.00 feet to the point of beginning; containing 1815 square feet.


CERTIFICATION

I hereby certify that the property described above has been surveyed under my responsible direction and supervision and that this map is a correct representation of the lot lines and dimensions and the principle lines of the permanent structures thereon.

Date 5-31-78

James B. Woodman
James B. Woodman
Registered Land Surveyor, S-1239

For: Charles Timm
516 Whitewater Street
Whitewater, WI 53190

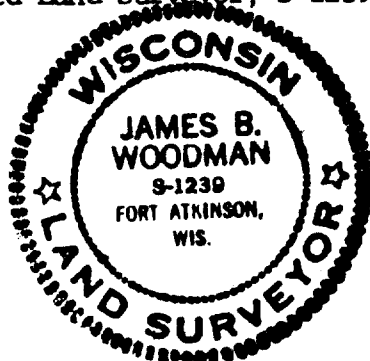

JN 76S-19