

DESCRIPTION OF PARCEL SURVEYED AS FURNISHED BY OWNER, ALAN HETH.

A parcel of land located in the Northwest $\frac{1}{4}$ of Section 5, T 4 N, R 15 E, City of Whitewater, Walworth County Wisconsin, and described as follows, to-wit: Commencing at the center of said Section 5; thence S $84^{\circ} 33'$ W 660.00'; thence N $39^{\circ} 14'$ E 1695.4'; along the centerline of Tratt St. to the place of beginning; thence S $86^{\circ} 06'$ W 183.00'; thence S $39^{\circ} 14'$ E 180.00'; thence S $86^{\circ} 06'$ W 1092.78'; thence N $4^{\circ} 11'$ W 521.50'; thence N $86^{\circ} 06'$ E 516.00'; thence S $41^{\circ} 27'$ E 302.72'; thence N $86^{\circ} 06'$ E 563.04' to the centerline of Tratt St.; thence S $41^{\circ} 27'$ E 29.26' along the centerline of Tratt St.; thence S $39^{\circ} 14'$ E 78.30' along the centerline of Tratt St. to the place of beginning, excepting therefrom that land bounded and described as follows: Land located in the NW $\frac{1}{4}$ of Section 5, T 4 N, R 15 E, City of Whitewater, Walworth County, Wisconsin and described as follows, to-wit: Commencing at the center of Section 5; thence South $84^{\circ} 33'$ W 660.00'; thence N $39^{\circ} 14'$ E 1695.4' along the centerline of Tratt St., thence S $86^{\circ} 06'$ W 183.00'; thence S $39^{\circ} 14'$ E 180'; thence S $86^{\circ} 06'$ W 1092.78'; thence N $4^{\circ} 11'$ W 427.30' to the place of beginning; thence continuing N $94.20'$; thence N $86^{\circ} 06'$ E 516.06'; thence S $41^{\circ} 27'$ E 118.81'; thence S $86^{\circ} 06'$ W on a line parallel with the North line of the property to the place of beginning. Also excepting therefrom Certified Survey No. 1186, recorded in the office of the register of Deeds for Walworth County, Wisconsin on September 16, 1981 in Volume 5 of Certified Surveyes on Page 258, as Document No. 72869.

DESCRIPTION OF ABOVE PARCEL WRITTEN FROM A FIELD SURVEY CONDUCTED JULY AND AUGUST
OF 1981 AND UPDATED MAY 10, 1985.

parcel of land located in the NW ¼ of Section 5, T 4 N, R 15 E, City of Whitewater Walworth County, Wisconsin described as follows:


Commencing at the center of said Section S; thence S $84^{\circ} 33'$ W., 660' to centerline of Tratt St; thence N $3^{\circ} 14'$ W., 1695.4' along the centerline of Tratt St. to the place of beginning;

hence S $86^{\circ} 04'$ W, 33.0' to a 1 $\frac{1}{2}$ " iron pipe found; thence continue S $86^{\circ} 04'$ W, 50.05' to a 1" iron pipe found; thence continue S $86^{\circ} 04'$ W, 101.21' to a 1" iron pipe found; thence S $3^{\circ} 14'E$, 80.01' to a 1" iron pipe found at the NW corner of Lot 1 of Certified Survey Map No. 1186, recorded in Vol. 5 of Certified surveys on Page 258; thence continue S $3^{\circ} 14'E$, 100.04' (recorded as 100.08') to a 1" iron pipe found at a corner of said Lot 1; thence S $85^{\circ} 59'$ W along the orth line of Block 4, Carriage Hill Subdivision, 126.44' to a 1 $\frac{1}{2}$ " solid iron rod found at the NW corner of said Block 4; thence S $86^{\circ} 01'$ 200' W, 864.26' to a 1 $\frac{1}{2}$ " iron pipe found; thence N $4^{\circ} 11' 20''$ W, 430.93' to a 1 $\frac{1}{2}$ " iron pipe found; thence S $86^{\circ} 15'$ E, 587.81' to a 1 $\frac{1}{2}$ " iron pipe found; thence S $41^{\circ} 16'E$, 183.97' to a 1 $\frac{1}{2}$ " iron pipe found; thence N $86^{\circ} 06'E$, 296.73' to a 1" iron pipe found; thence continue N $86^{\circ} 06'E$, 203.04' to a 1 $\frac{1}{2}$ " iron pipe found; thence continue N $86^{\circ} 06'E$, 3.15' to the centerline of Tratt St.; thence S $41^{\circ} 33'E$ along said centerline 0.08'; thence S $3^{\circ} 14'E$, 78.44' to the point of beginning. This parcel contains 403,600 square feet of area (9.265 acres).

SURVEYOR'S CERTIFICATE

, Glen L. Northrop, Registered Land Surveyor, hereby certify that on July 14
and 17, 1981 a survey was made under my direction and control of the property
described and mapped hereon and that on May 10, 1985 I made a partial resurvey
of parts of the north, east and south boundaries to locate the existing concrete
foundation wall for the existing building under construction on this site and
that this map is a true representation of the field surveys made in 1981 and
on May 10, 1985 and is correct to the best of my knowledge and belief.

ated this 14th day of MAY, 1985 at Cambridge, Wisconsin.
REVISED FOR IRONS FOUND DISTURBED
1 DEC 1985 MARCH 11 1996
Glen L. Northrop S-982

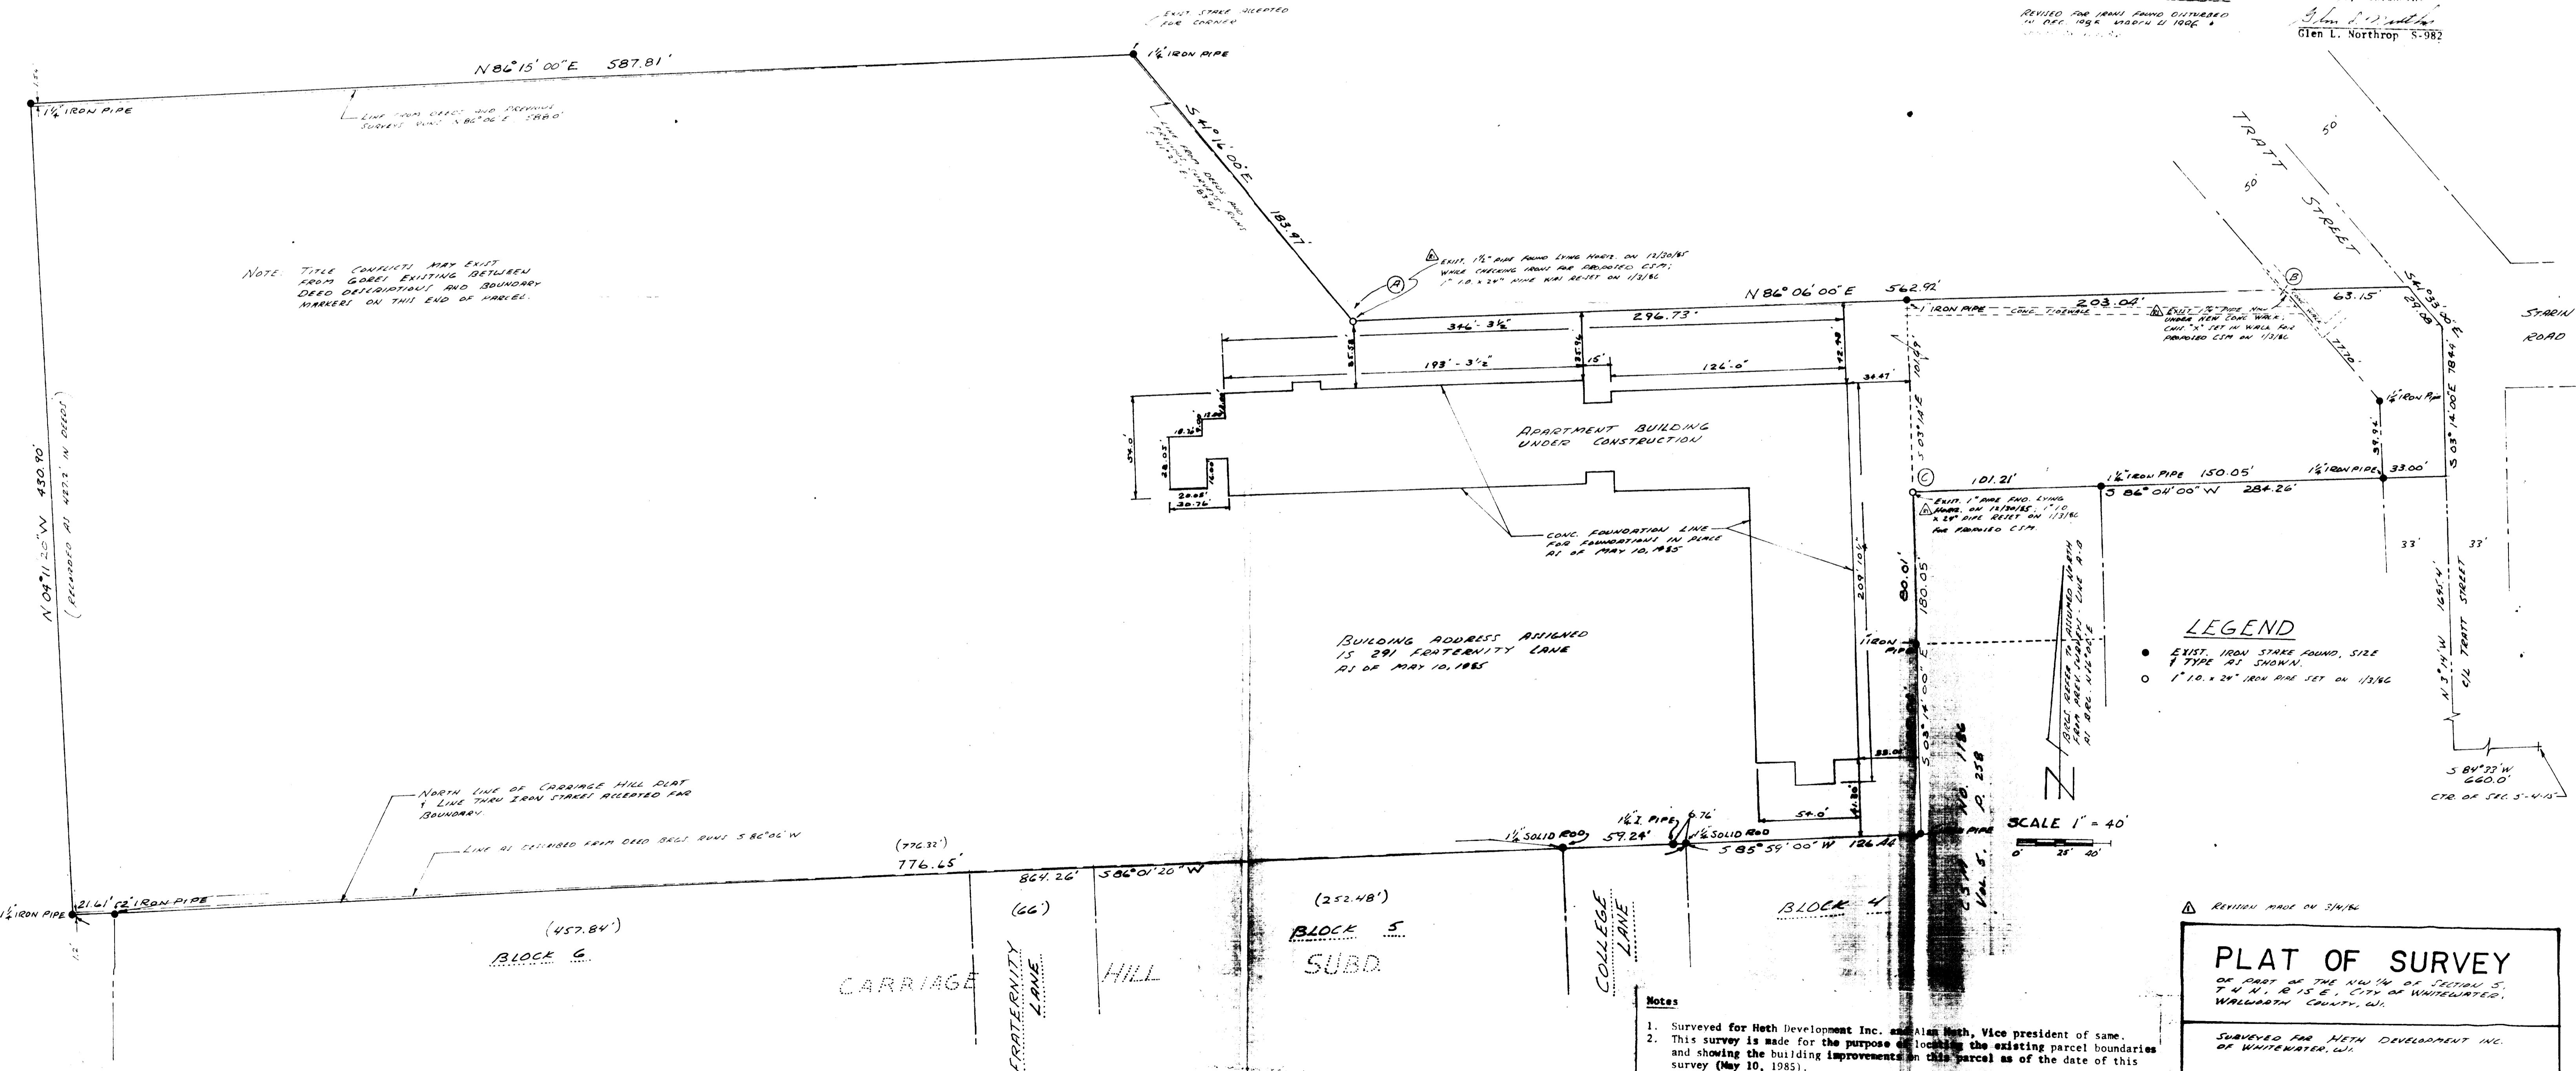

<h1>PLAT OF SURVEY</h1> <p>OF PART OF THE NW 1/4 OF SECTION 5, T 4 N., R 15 E., CITY OF WHITEWATER, WALWORTH COUNTY, WI.</p> <p>SURVEYED FOR METH DEVELOPMENT INC. OF WHITEWATER, WI.</p> <p>SURVEYED BY GLEN L. NORTHROP, S-982 OF ABEX SURVEY LTD., 136 W. MAIN STREET, P.O. BOX 369, CAMBRIDGE, WI. 53523 TEL. 608-423-3331</p> <p>ELD SURVEY BY G. NORTHROP JL7, 1981 AND MAY, 1983 RATED MAY 14, 1983</p> <p>PRINT DATE: 2/6/81</p>	
ORD. NO AB 1046-85	DRG NO 1046
SHEET 1 OF 1	