

FARRIS, HANSEN & ASSOCIATES, INC.

7 RIDGEWAY COURT, P.O. BOX 487, ELKHORN, WISCONSIN


TEL. 414-723-2098

LOCATION: LOT 8 OF BLOCK 4 OF TRIPP'S ADDITION TO THE CITY OF WHITEWATER, WALWORTH COUNTY, WI.

MAP LEGEND

- O = IRON PIPE STAKE FOUND
- = IRON PIPE STAKE SET
- = IRON ROD STAKE FOUND
- = IRON ROD STAKE SET
- = CONCRETE MONUMENT FOUND
- (XXXXX) = RECORD DIMENSION

WORK ORDERED BY: PAUL DRAVUS


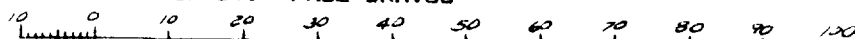


MAP SCALE IN FEET

(XXXXX) = RECORD DIMENSION

NOTE: FOUND 4 IRON PIPE STAKES ALONG JAMES STREET RIGHT OF WAY ON LOTS 6 THROUGH 11 IN CLOSE AGREEMENT WITH THE RECORDED LOT WIDTHS, ACCEPTED THESE STAKES AND PROPORTIONED THE LOT FRONTAGES ACCORDINGLY. FOUND AND ACCEPTED IRON PIPE STAKE BETWEEN LOTS 11 AND 12 ON ANN STREET, SEARCHED FOR AND FOUND NO OTHER IRON PROPERTY STAKES IN THE REMAINDER OF ANN STREET RIGHT OF WAY TO THE EAST. ACCEPTED THE SUBSTANTIAL AND APPARENTLY ANCIENT FENCE BETWEEN LOTS 2 AND 3 AT ANN STREET AS THE BEST AVAILABLE EVIDENCE OF ORIGINAL LOT LAYOUT AND PROPORTIONED LOTS 3 THROUGH 11 ACCORDINGLY.

2 SOUTH EDGE OF JAMES ST NO CURB

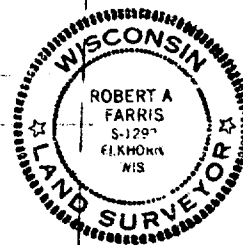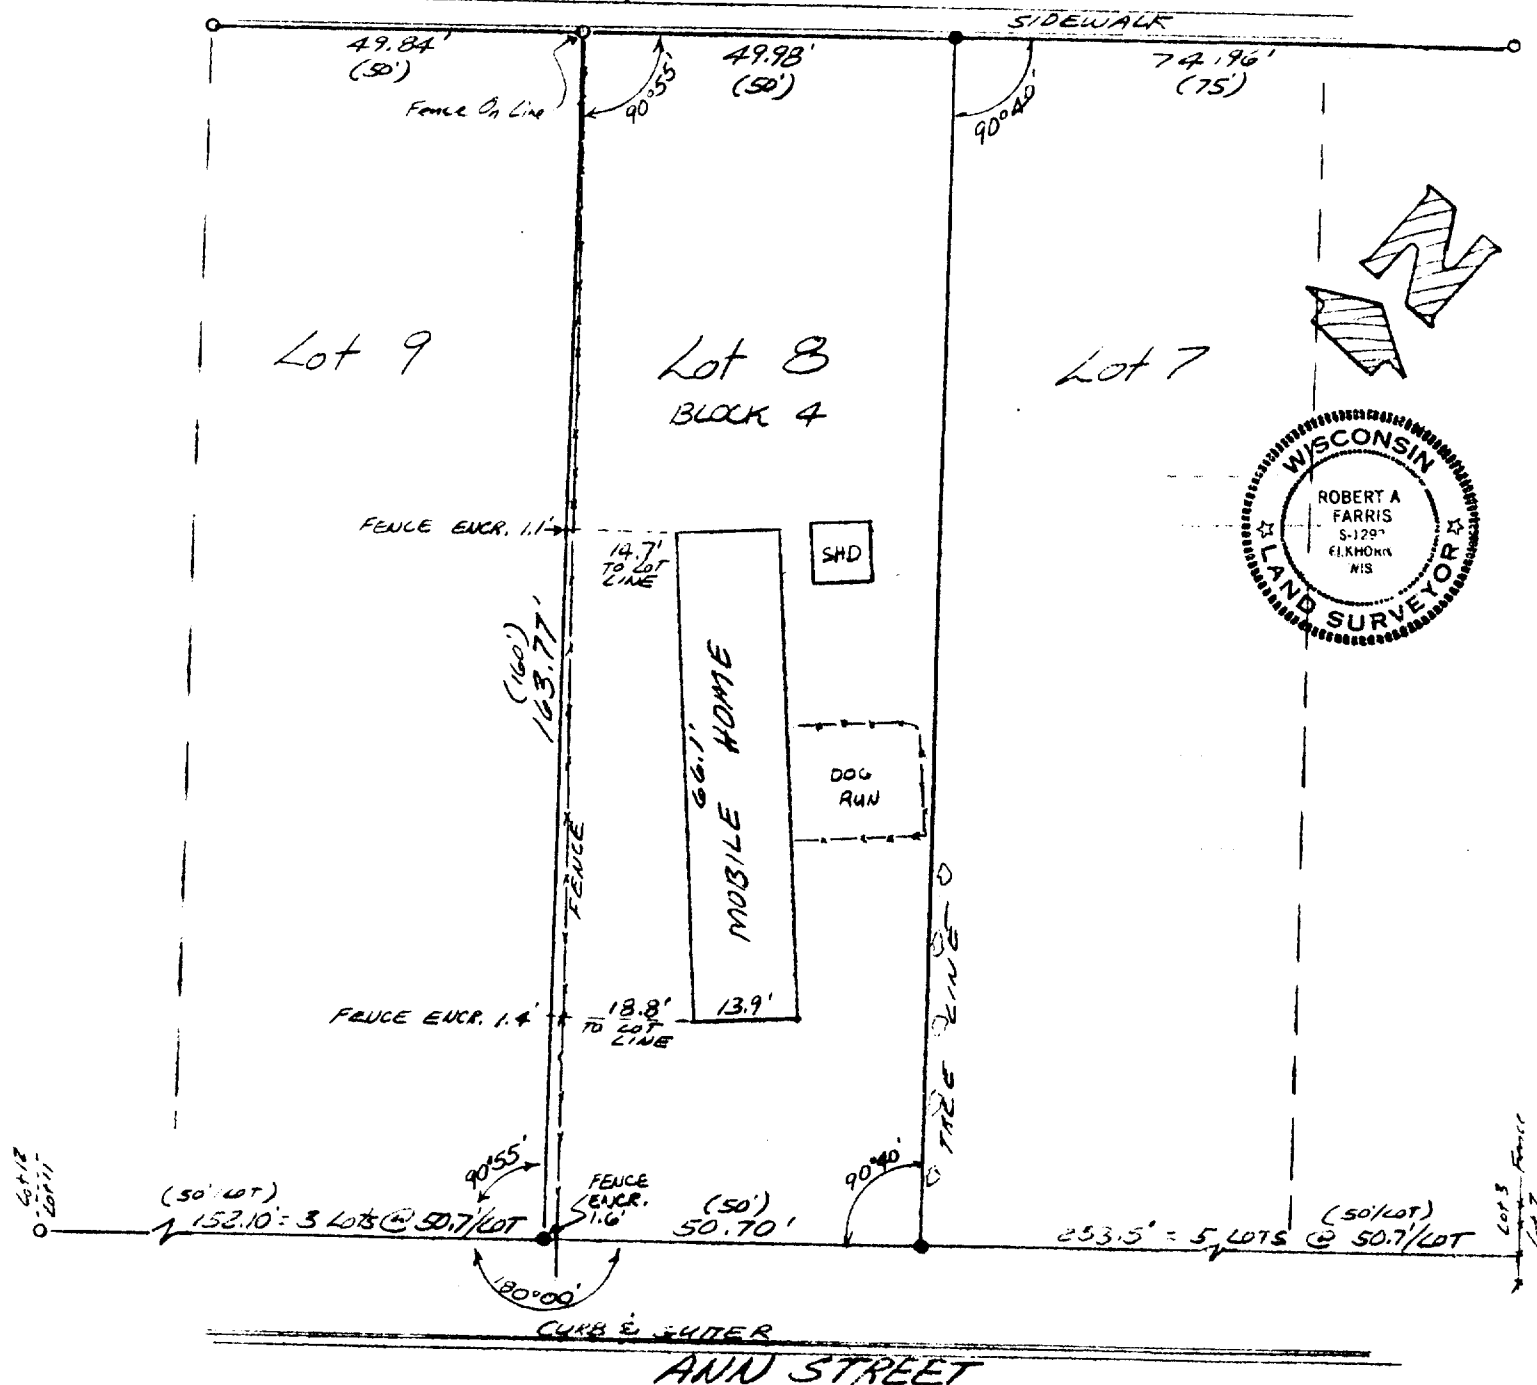

I hereby certify that the above described property has been surveyed under my direction and that the above map is a true representation thereof and shows the size and location of the property, its exterior boundaries, the location of all visible structures and dimensions of all principal buildings thereon, boundary fences, apparent easements, roadways and visible encroachments, if any. This survey is made for the use of the present owners of the property, and also those who purchase, mortgage, or guarantee the title thereto within one year from the date hereof.

DATED: OCTOBER 15, 1987

Robert A. Farris

PROJ. NO. 2896

