


# ABELL SURVEYING & MAPPING

DELAVER, WISCONSIN 53115

414-728-6737

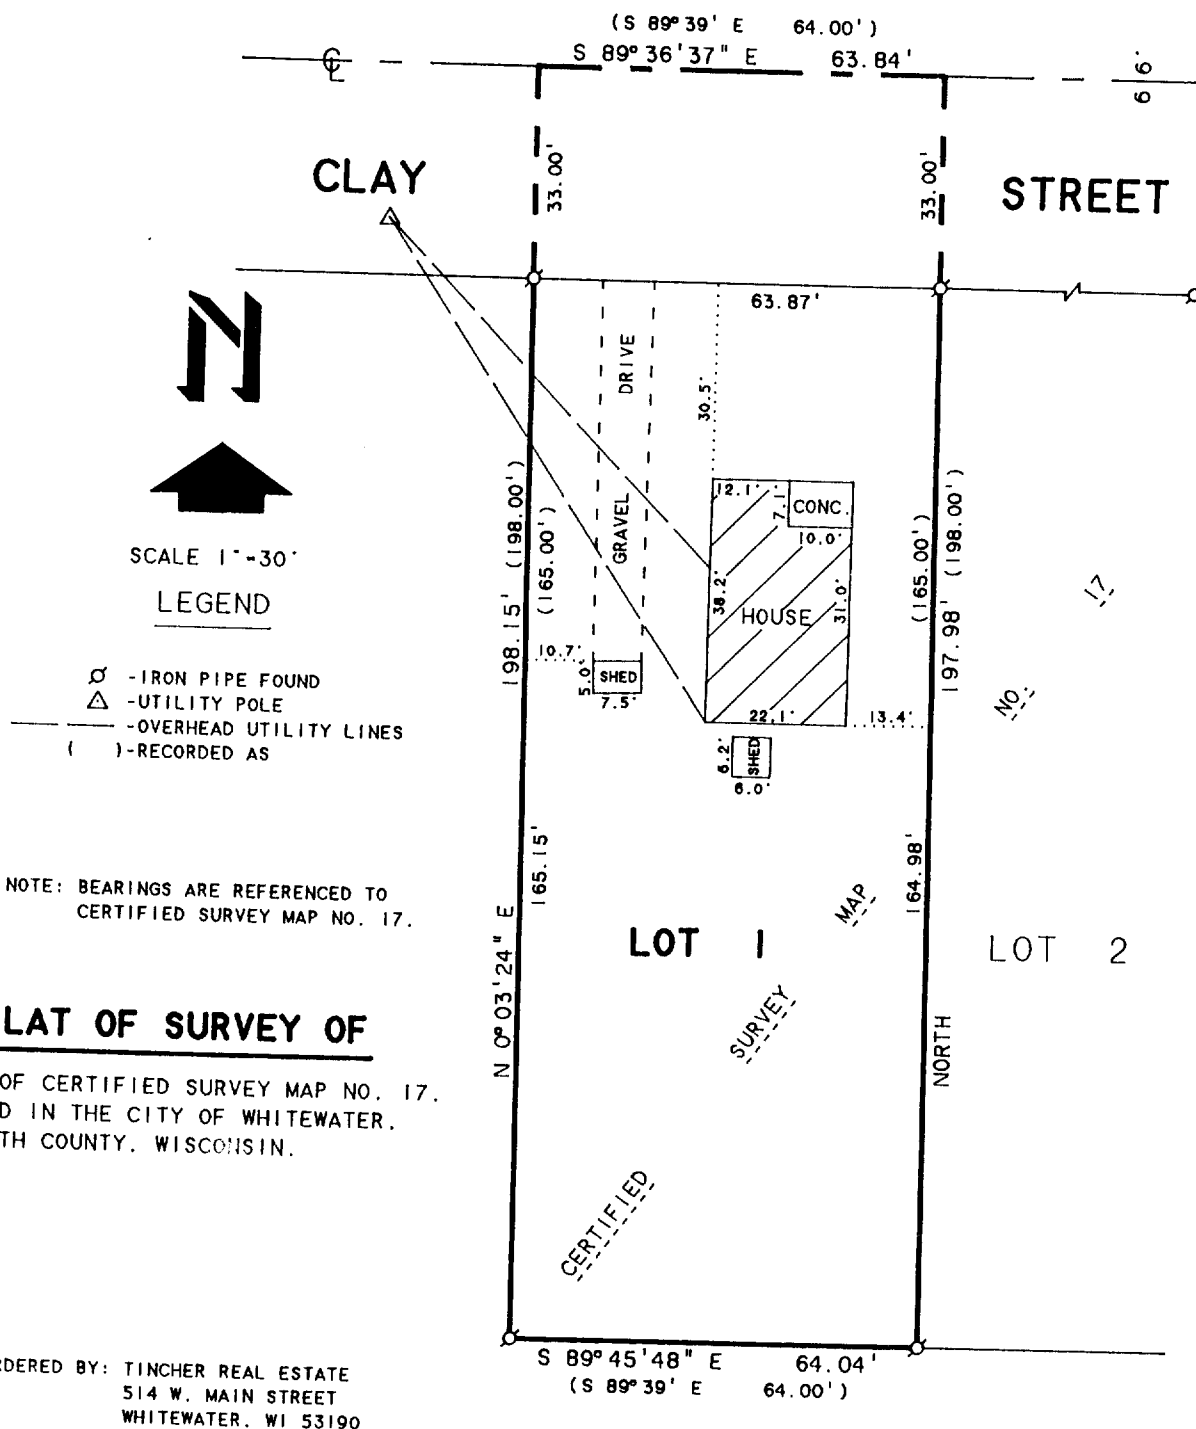

010-456

1A-17-1