
Lot 49 and that part of Outlot 5 of Mound Park Acres, a subdivision located in the NE. SE. SW and NW 1/4's of the SE 1/4  $\,$ and in the SE 1/4 of the NE 1/4, all in Section 6,74M, R15E, City of Whitewater, Walworth County, Wisconsin described as follows: Begin at the NE corner of Lot 49 of Mound Park Acres; thence N2^46'15"N, along the east line of Outlot 5, 2008 feet; thence N87^33'00'W, parallel with the north line of said Lot 49, 78.18 feet; thence S14^01'11"W 20.4/ feet to the NW corner of said Lot 49; thence S87^33'00"E, on the north line of said Lot 49, 84.10 feet to the place of beginning.

SURVEYED FOR: Crispell/Snyder, Inc. 114 W. Court St. Elkhorn, WI 53121

MOTE: This is a lot line adjustment.

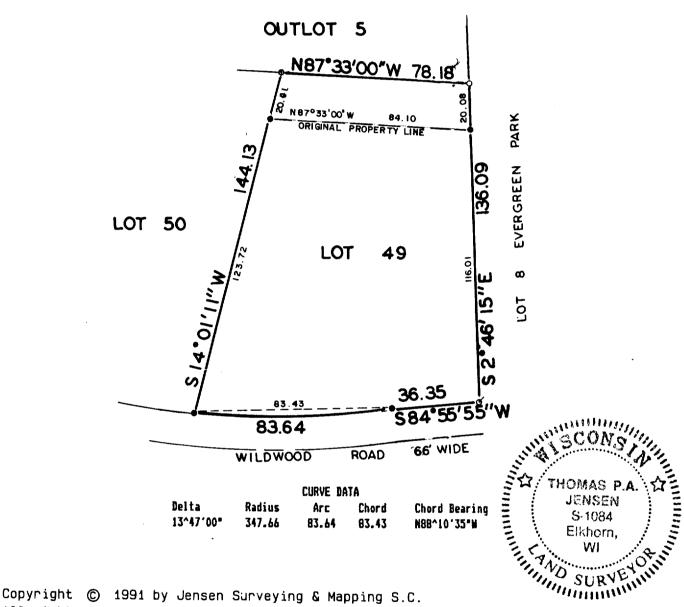

All rights reserved. No part of this survey plat may be reproduced or transmitted in any form by any means - graphic, electronic, or mechanical, including photocopying, tracing, or information storage and retrieval systems - without permission in writing from Thomas P.A. Jensen.

I, Thomas P.A. Jensen, Wisconsin Registered Land Surveyor, do hereby certify that this survey was performed by me, or under my direction, in full compliance with the owner's/agent's instructions and Chapter A-E 7 of the Wisconsin Administrative Code ' Minimum Standards For Property Surveys ', and that this map is an accurate representation thereof to the best of my knowledge and belief. CEIVE

FEB | 0 1993

Note: This survey plat is not certified unless signed and sealed in red ink.

Thomas P.A. Jensen

R.L.S. 1084

Legend

Found iron rod

Set iron rod 3/4 dia. ~ FOUND IRON PIPE

Jensen Surveying & Mapping S.C.

45 South Wisconsin Street P.O. Box 322 Elkhorn, Wisconsin. 53121. (414) 723-3434

Mapping date: 11/11/91, Revisions:

Sheet 1 of 1 Sheets

Job reference number: 1991.198B

10-478

Scale: 1 = 4040 80 120