
## **PLAT OF SURVEY**

Beginning at the SE. corner of Lot three (3) in Block One (1) in Wilson's Addition to the Village (now City) of Whitewater; thence West along the North line of North Street, forty-three and one-half (43 1/2) feet; thence North parallel with the West line of George Street 114 feet; thence East parallel with the North line of North Street 43 1/2 feet to the West line of George Street; thence South along the West line of George Street to the place of beginning, being a part of Lot Three (3), Block One(1) of Wilson's Addition to the Village (now City) of Whitewater, Walworth County, Wisconsin.

Surveyed for: John Tincher

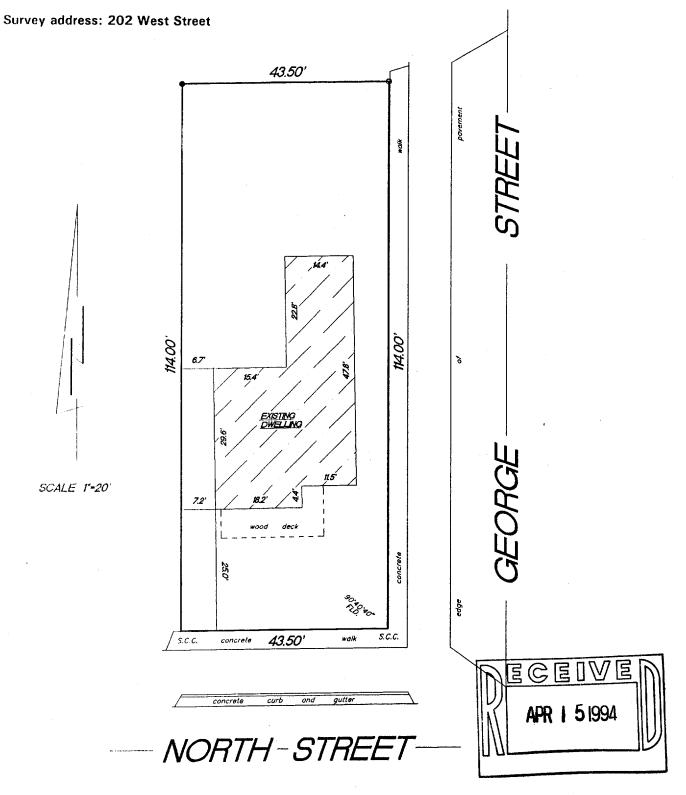

- FOUND IRON PIPE
- SET 1" IRON PIPE
- s.c.c. SET CHISELED CUT

"I hereby certify that I have surveyed the above described property and that the above map is a true representation thereof and shows the size and location of the property, its exterior boundaries, the location of all visible structures and dimension of all principal buildings thereon, boundary fences, apparent easements, roadways and encroachments if any."

"This survey is made for the use of the present owners of the property, and also those who purchase, mortgage or guarantee the title thereto within one year from date hereof."

W362 S10227 Lewin Lane Eagle Wisconsin 53119 (414) 594-3484

**KETTLE MORAINE SURVEYING** 

Terrance E. Pisarek R.L.S.

THIS IS NOT AN ORIGINAL SURVEY UNLESS THE SEAL IS RED.

 DATE
 TEP/DRF
 TEP
 94033

 DATE
 FIELD WORK BY
 DRAWN BY
 JOB NUMBER