

C.S.M. # 929 (HOME LUMBER CO.)

RAILROAD MAIN TRACK

SPUR TRACK

FRANKLIN ST.

BULK PLANT

HOUSE

BLK 7 TRIPPS ADD.


METAL BUILDING

METAL BUILDING

FRAME & METAL BUILDING

ANN ST.

TRIPP ST.

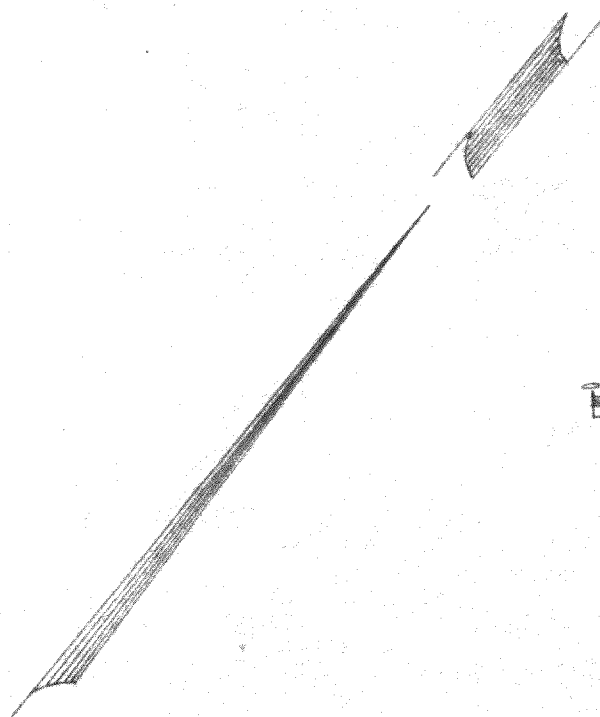



NOTE: This property is described in Volume 29 page 334 and Volume 126 page 547.

This property is subject to any and all easements or agreements either recorded or unrecorded.

Lot dimensions are shown as recorded on surveys by ABEX LTD and were not necessarily verified.

Buildings were field located on 9/15/95 and 9/19/95

Prepared for: Attorney Mitch Simon  
304 W. Main Street  
Whitewater, WI 53190

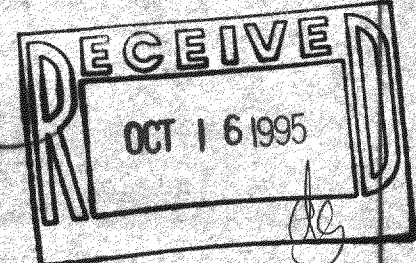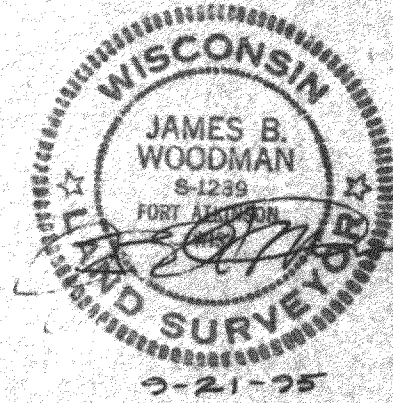

**WOODMAN, ANDERSON & ASSOCIATES**  
Registered Land Surveyors  
210 MADISON AVENUE  
FORT ATKINSON, WISCONSIN 53538  
(414) 563-8162

JAMES B. WOODMAN  
Registered Land Surveyor

MARK E. ANDERSON  
Registered Land Surveyor

**SITE PLAN**

PART OF THE SW 1/4 OF THE SW 1/4 OF SECTION 4, T4N, R15E, CITY OF WHITWATER, WI

DATE	DATE	SCALE
DSN. 12W 9-21-95	REV. 9-21-95	1"=40'
APPX. 12W 9-21-95	REV. 9-21-95	JOB NO. 553-87
		SHEET 1 OF 1

/UP-326

/TR-48

10-552