
PLAT OF SURVEY SEE LEGAL DESCRIPTION ON SHEET 2

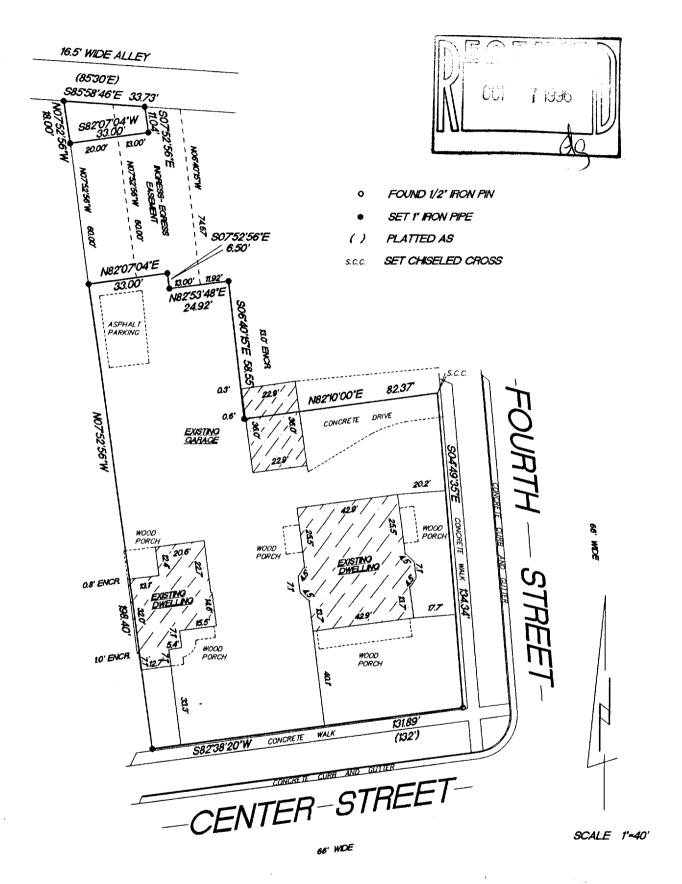

"I hereby certify that I have surveyed the above described property and that the above map is a true representation thereof and shows the size and location of the property, its exterior boundaries, the location of all visible structures and dimension of all principal buildings thereon, boundary fences, apparent easements, roadways and encroachments if any."

"This survey is made for the use of the present owners of the property, and also those who purchase, mortgage or guarantee the title thereto within one year from date hereof."

9/24/96 DRF/JPK
DATE FIELD WORK BY

KETTLE MORAINE 362 S10227 Lewin Lane

W362 S10227 Lewin Lane's Eagle, Wisconsin 53119 Terrance E.Pisarek R.L.S.

(414) 594-3484 fax (414) 594-5904

THIS IS NOT AN ORIGINAL SURVEY UNLESS THE SEAL IS RED.

TEP 96041

DRAWN BY JOB NUMBER SHEET 1 OF 2

PLAT OF SURVEY

A part of Lots 1 and 2 in Block 11, Original Town, City of Whitewater, Walworth County, Wisconsin, More particularly described as follows, to-wit: Commencing at the Southeast corner of said Block 11; thence North 4 degrees 49' 35" West 134.34 feet; thence South 82 degrees 10' 00" West 82.37 feet; thence North 6 degrees 40' 15" West 58.55 feet; thence Westerly 21 feet to the centerline of Lot 2; thence Northerly parallel to the West line of Lot 2, 6.5 feet; thence Westerly along a line drawn at right angles to the West line of said Lot 2 to a point on the West line of said Lot 2 which is 78 feet Southerly of the Northwest corner of said Lot 2; thence Southerly along the West line of said Lot 2 to the Southwest corner of Lot 2; thence Easterly along the South lines of Lots 2 and 1 to the point of beginning.

ALSO a part of Lot 2 in Block 11 of the Original Town, City of Whitewater, described as follows, to-wit: Commencing at the Northwest corner of said Lot and running thence Southerly along the West line of said Lot, 18 feet; thence Easterly at right angles to the West line 33' to the centerline of said lot; thence Northerly parallel with said West line 10.5 feet to the South line of the alley through said Block; thence Westerly along the North line of said lot to the place of beginning.

ALSO a right of way for pedestrian and vehicular ingress and egress over, upon, across and through the following described portions of Lot 2 of Block 11 of the Original Town, City of Whitewater, Walworth County, Wisconsin, to-wit: Commencing at the Northwest corner of said Lot 2; thence Southerly along the West line of said Lot 2, 78 feet; thence Easterly at right angles to the West line of said Lot 2, 20 feet to the point of beginning; thence continue Easterly at right angles to the West line of said Lot 2, 13' to the centerline of said Lot 2; thence Southerly parallel to the West line of said Lot 2, 6.5 feet; thence Easterly on a line drawn at right angles to the East line of said Lot 2, 13'; thence Northerly parallel to the East line of said Lot 2 to the South line of the Alley through said Block; thence Westerly along the North line of said Lot to a point which is 20' Easterly of (measured at right angles to) the West line of said Lot 2; thence Southerly parallel to the West line of said Lot 2 to the place of beginning.

DECEUVED OCT 47 1996

1-2

9/24/94

Sheet 2 of 2