


PLAT OF SURVEY

LOT 10, BULKLEY AND TRATT'S ADDITION TO THE CITY OF WHITEWATER, being a part of the Northeast 1/4 of Section 5, Town 4 North, Range 15 East, in the City of Whitewater, Walworth County, Wisconsin.

Surveyed for: Tinch Realty


Survey address: 271 North Prairie Street

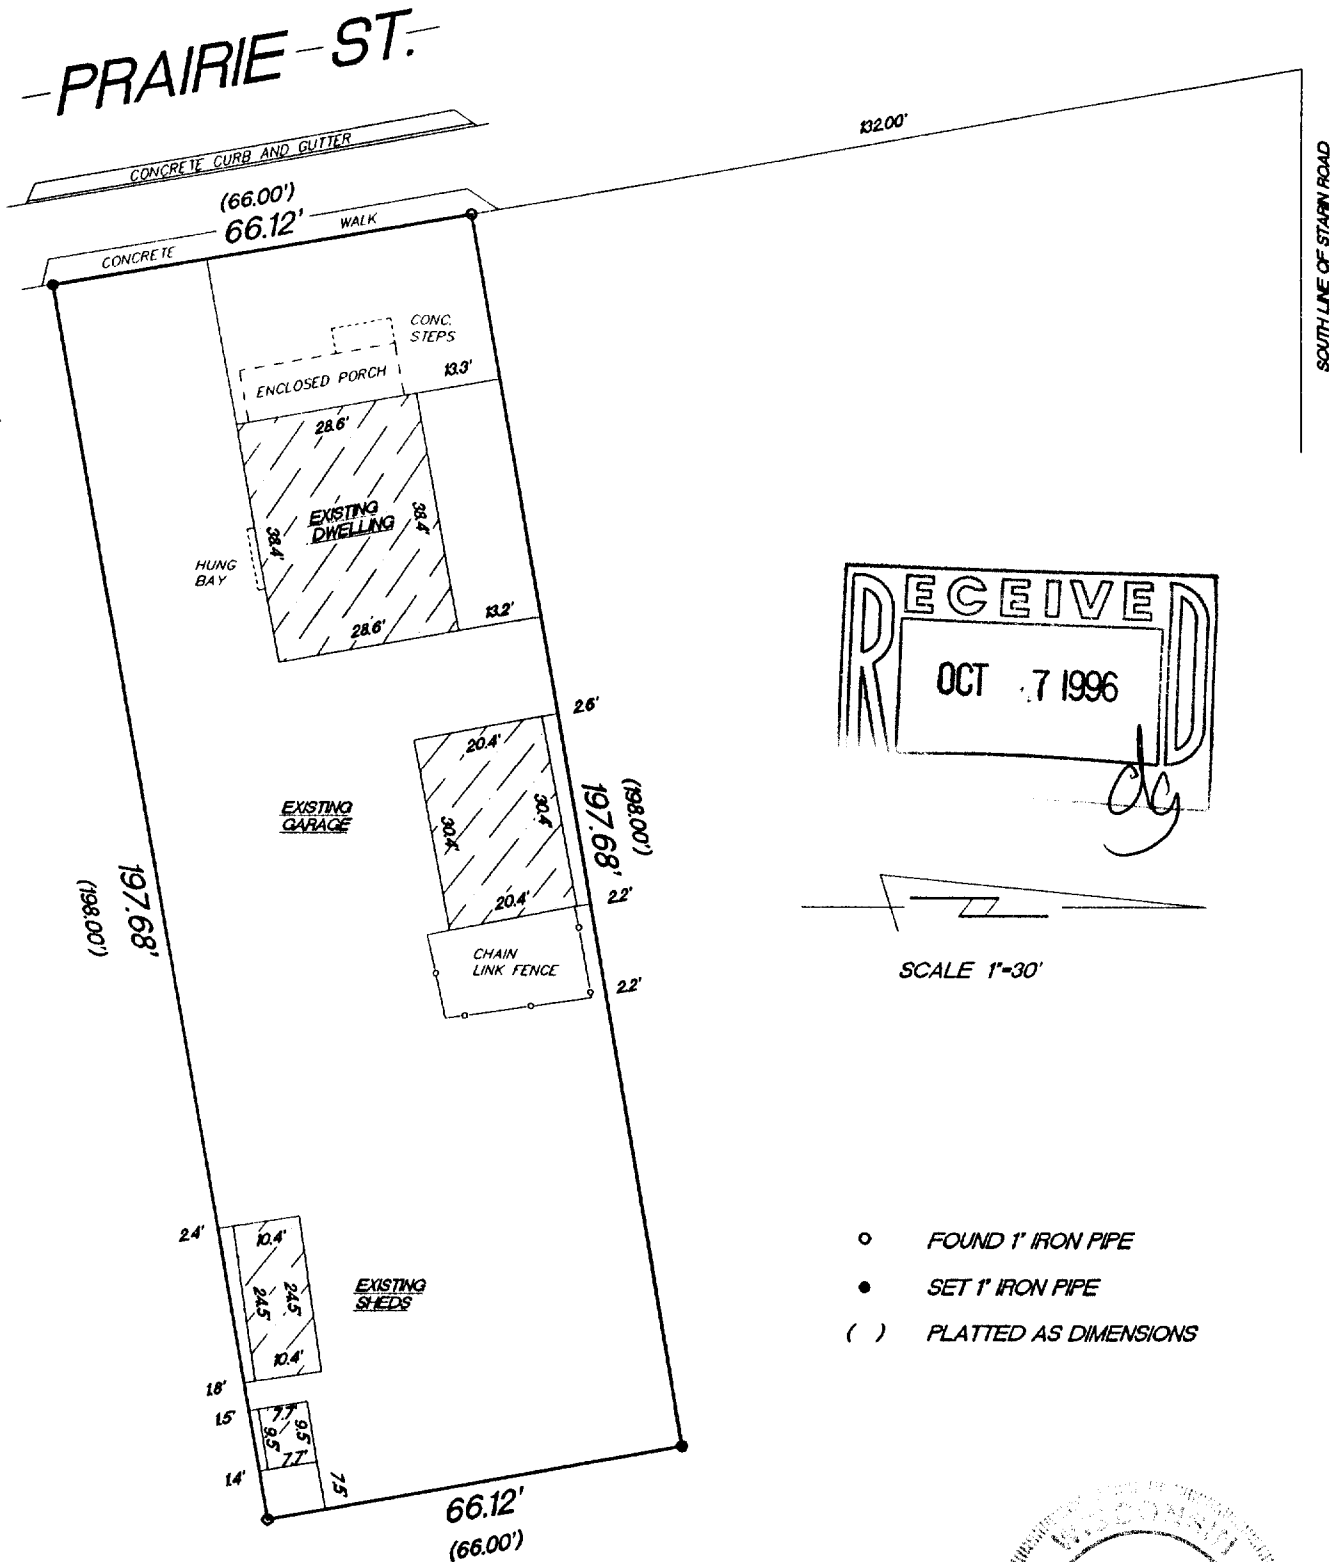

- FOUND 1" IRON PIPE
- SET 1" IRON PIPE
- () PLATTED AS DIMENSIONS

"I hereby certify that I have surveyed the above described property and that the above map is a true representation thereof and shows the size and location of the property, its exterior boundaries, the location of all visible structures and dimension of all principal buildings thereon, boundary fences, apparent easements, roadways and encroachments if any."

"This survey is made for the use of the present owners of the property, and also those who purchase, mortgage or guarantee the title thereto within one year from date hereof."

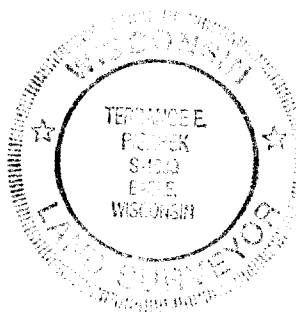

W362 S10227 Lewin Lane
Eagle, Wisconsin 53119
Terrance E. Pisarek R.L.S.

(414) 594-3484
fax (414) 594-5904

THIS IS NOT AN ORIGINAL SURVEY UNLESS THE SEAL IS RED.

8/14/96

TEP/JPk

TEP

96136

DATE

FIELD WORK BY

DRAWN BY

JOB NUMBER

/BUL-11
10-579