

WEST MAIN STREET

ELIZABETH STREET

SITE BENCH MARK:
SANT. SEWER MANHOLE:
RIM: 865.11
INV: 854.50

STORY BUILDING

STATE OF WISCONSIN
COUNTY OF RACINE

The above-described property has been surveyed under my direction and the above map is a correct representation thereof.

DATED AT: North Cape, THIS 27th DAY OF May, 1996.

P. L. Bailey
AMERICAN SURVEYING COMPANY, INC.
PETE L. BAILEY, RLS NO. 1398


/WUP-163A



CITY OF WATERWATER

AMERICAN SURVEYING COMPANY, INC.
12207 C.T.H. "K", NORTH CAPE
FRANKSVILLE, WIS.
(414) 835-4774

LOCATION SURVEY
SUPERAMERICA STORE #4189
1184 WEST MAIN STREET
PREPARED FOR: SIGMA ENVIRONMENTAL

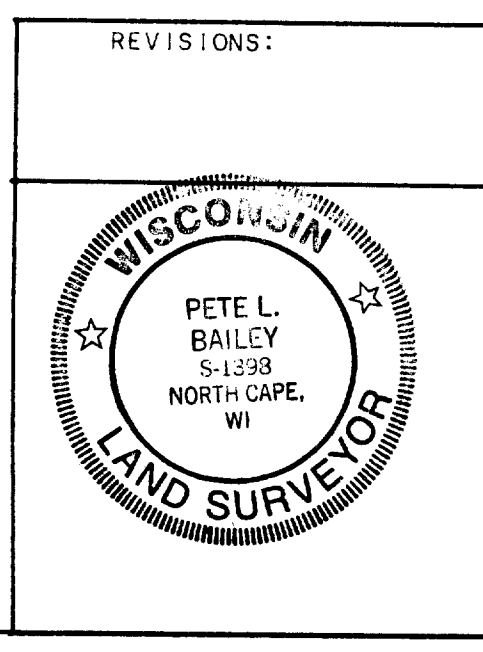

DRAWN: PLB	APPROVED:	JOB NUMBER: 96103	SHEET 1 OF 1
DATE: 04/15/1996	DATE:	FILE NUMBER: JN96134	