

RECEIVED
 OCT 7 1997
Sted

BASIS OF BEARINGS:
 THE E. LINE OF THE SW 1/4, SEC. 5, T4N, R15E
 BEING "NORTH"

NOTE: No plat was discovered which reflected any of the mnts fd. in the vicinity of WUP-206. Analysis of positions, disclosed that they approximate positions based on an assumption of a 2840' N/S 1/4 line, and measurement from the exist. Ctr. Sec. Corner. In as much as neither the assumption nor the method are deemed valid, they have been rejected.

A Plat reflecting this Monumentation indicates that while the description is controlled from the NORTH, monumentation was set based on Measurement from the SOUTH.


- Fd. 1/2" IP 4.32N/0.21E of Rec. Position
 - Fd. 3/4" IP 3.85S/0.40E of Rec. Position
 - Fd. 1/2" Rod 3.84S/0.14E of Rec. Position
 - Fd. 1" IP 0.17N/0.15E of Rec. Position
- Mnts Fd. from this position S'y, appear to substantially conform to Rec (N/S)

SURVEYOR'S CERTIFICATE
 I, JAMES K. LANGONE, REGISTERED LAND SURVEYOR, CERTIFY THAT I HAVE SURVEYED THE PROPERTY DESCRIBED HEREON AND THAT THE PLAT SHOWN HEREON IS A CORRECT REPRESENTATION OF THE BOUNDARIES THEREOF.

DATE: 10/6/97

JAMES K. LANGONE
 S-1347
 WHITEWATER
 JAMES K. LANGONE
 REGISTERED LAND SURVEYOR, S-1347

LEGAL DESCRIPTION:
 IN THE SE 1/4, OF THE SW 1/4, SEC. 5, T4N, R15E, IN THE CITY OF WHITEWATER, WALWORTH COUNTY, WISCONSIN BOUNDED AS FOLLOWS:
 BEGINNING ON THE WEST LINE OF PRINCE ST., AT A POINT 16 RODS SOUTH OF THE N. LINE OF SAID SE 1/4 AND RUNNING THENCE WEST AND PARALLEL WITH THE SAID NORTH LINE, 12 RODS; THENCE SOUTH 89 FEET; THENCE EAST 12 RODS, TO THE WEST LINE OF PRINCE ST.; THENCE NORTH ON SAID WEST LINE, TO THE PLACE OF BEGINNING, AND BEING A PART OF OUTLOT 3 OF SALISBURY'S OUTLOTS.

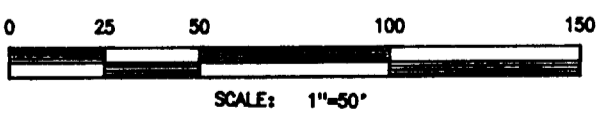

- NOTES:**
- () - Indicates Record Distance
 - R&M - Indicates Dist. Record & Measured
 - - Indicates Mnt. FD. as Noted
 - - Indicates SET 3/4" Iron Rod
 - ⊙ - Indicates POSITION established by DOT ties for Mnt. Displaced by Highway Construction being done at the time initial field work was accomplished. It should be noted that visual inspection has disclosed that DOT disks have subsequently been set.

JAMES K. LANGONE		
LAND SURVEYS & CIVIL ENGINEERING		
N339 Co. Rd. "W" (Upper)		Whitewater, WI. 53190-2842
(414) 473-4119		
SCALE	1" = 50'	APPROVED BY
DATE	9/10/97	DRAWN BY
		REVISOR
PLAT OF SURVEY		
IN THE SE 1/4 OF THE SW 1/4, SEC. 5, T4N, R15E		
CLIENT	YOUNG	DRAWING NUMBER
		97-126

1/WUP-205

010-613