


Plat of Survey

The East 1/2 of Lot 2, the West 1/2 of Lot 3, and the South 1/2 of the vacated alley, all in Block 3, George Dann's Addition to the City of Whitewater, located in the Northeast 1/4 of Section 4, Town 4 North, Range 15 East, in the City of Whitewater, Walworth County, Wisconsin.

Surveyed for: Century 21, Realty Search

Survey address: 442 North St.

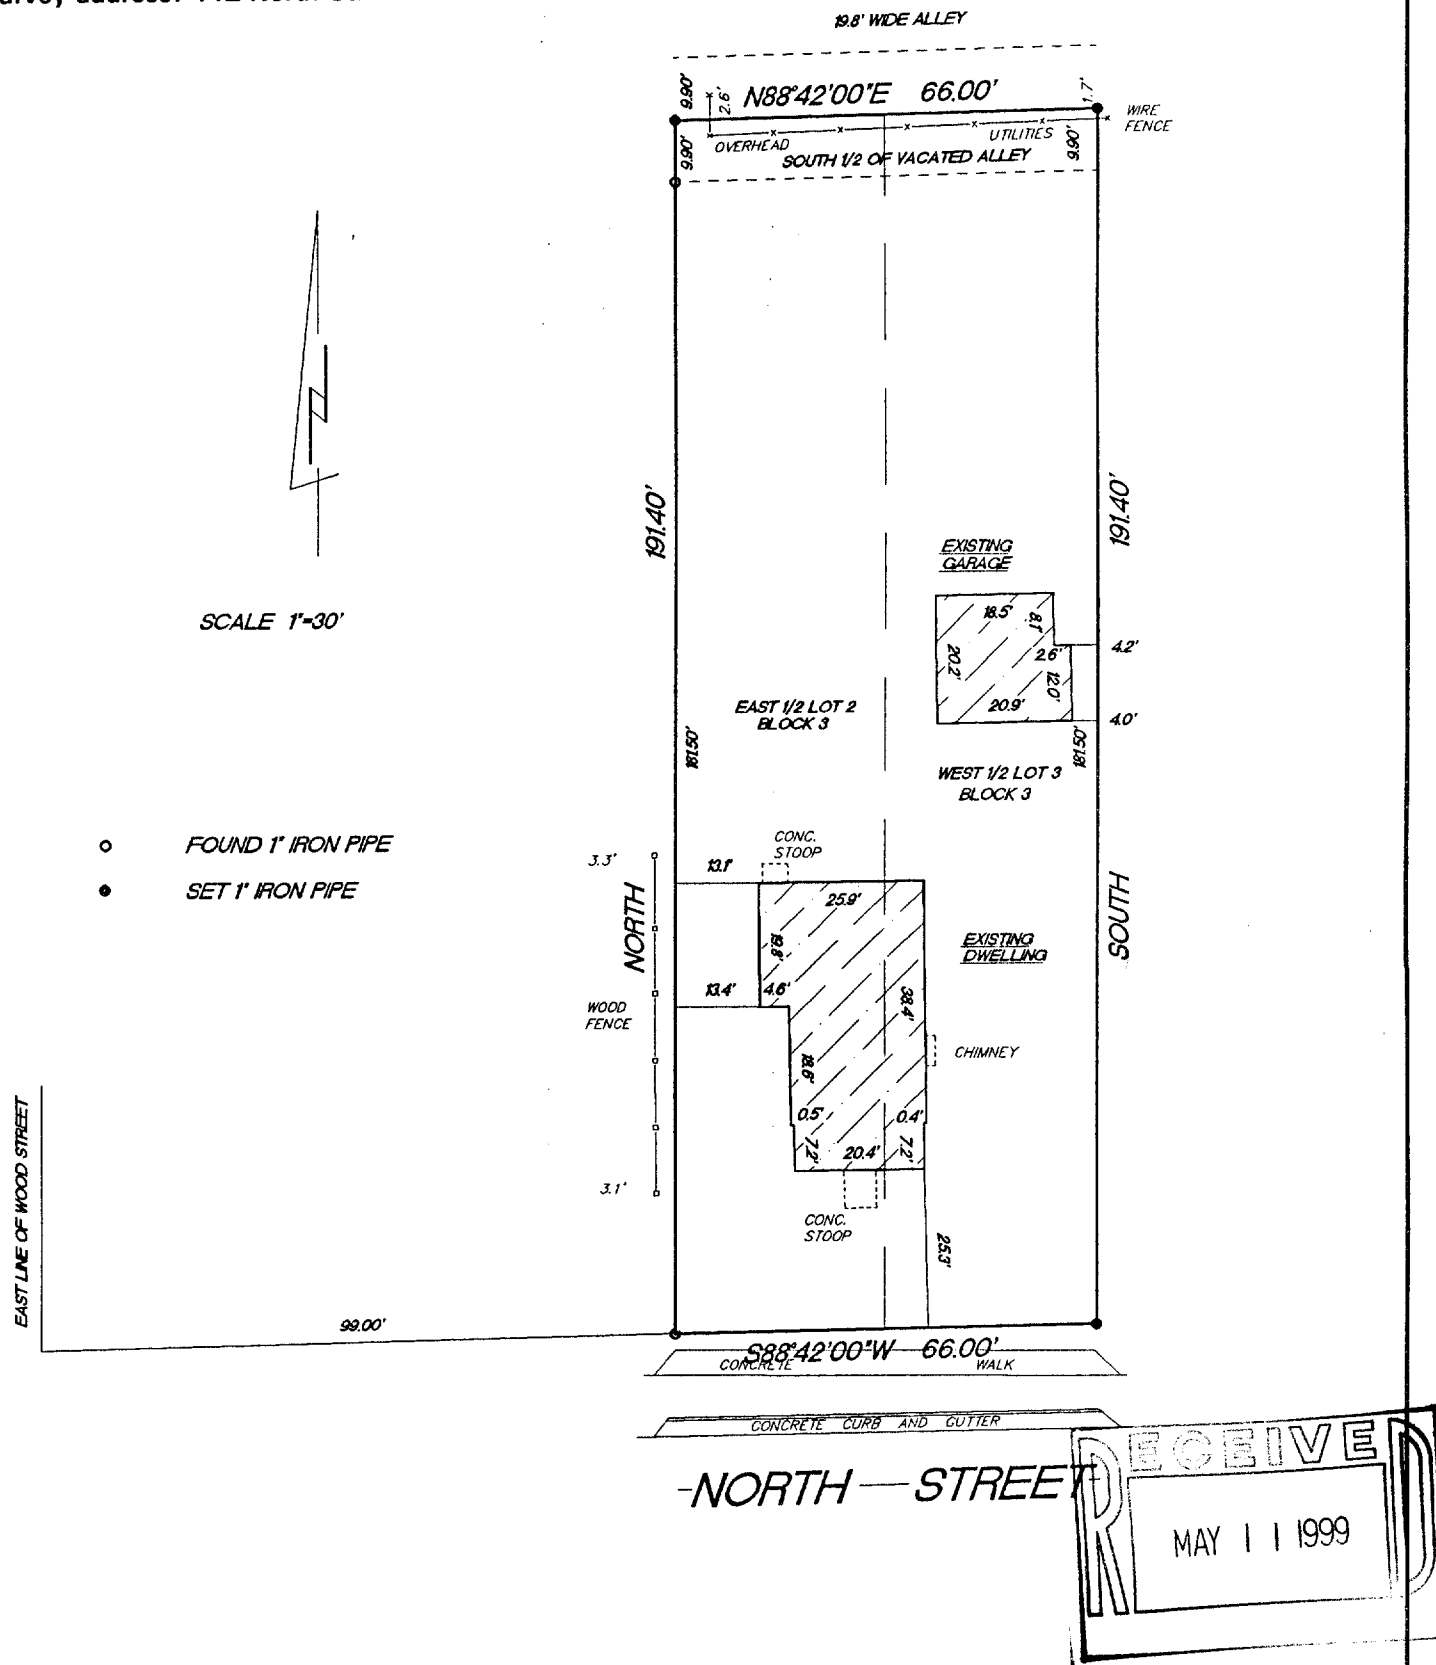

"I hereby certify that I have surveyed the above described property and that the above map is a true representation thereof and shows the size and location of the property, its exterior boundaries, the location of all visible structures and dimension of all principal buildings thereon, boundary fences, apparent easements, roadways and encroachments if any."

"This survey is made for the use of the present owners of the property, and also those who purchase, mortgage or guarantee the title thereto within one year from date hereof."



W362 S10227 Lewin Lane
Eagle, Wisconsin 53119
Terrance E. Pisarek R.L.S.

(414) 594-3484
fax (414) 594-5904

THIS IS NOT AN ORIGINAL SURVEY UNLESS THE SEAL IS RED.

3/22/99
DATE

TEP/DW
FIELD WORK BY

TEP
DRAWN BY

99070
JOB NUMBER

1/DA-18

010-636