


ABELL  
SURVEYING & MAPPING

1140 SEQUOIA STREET • DELAVAN, WISCONSIN 53115  
262-728-6737

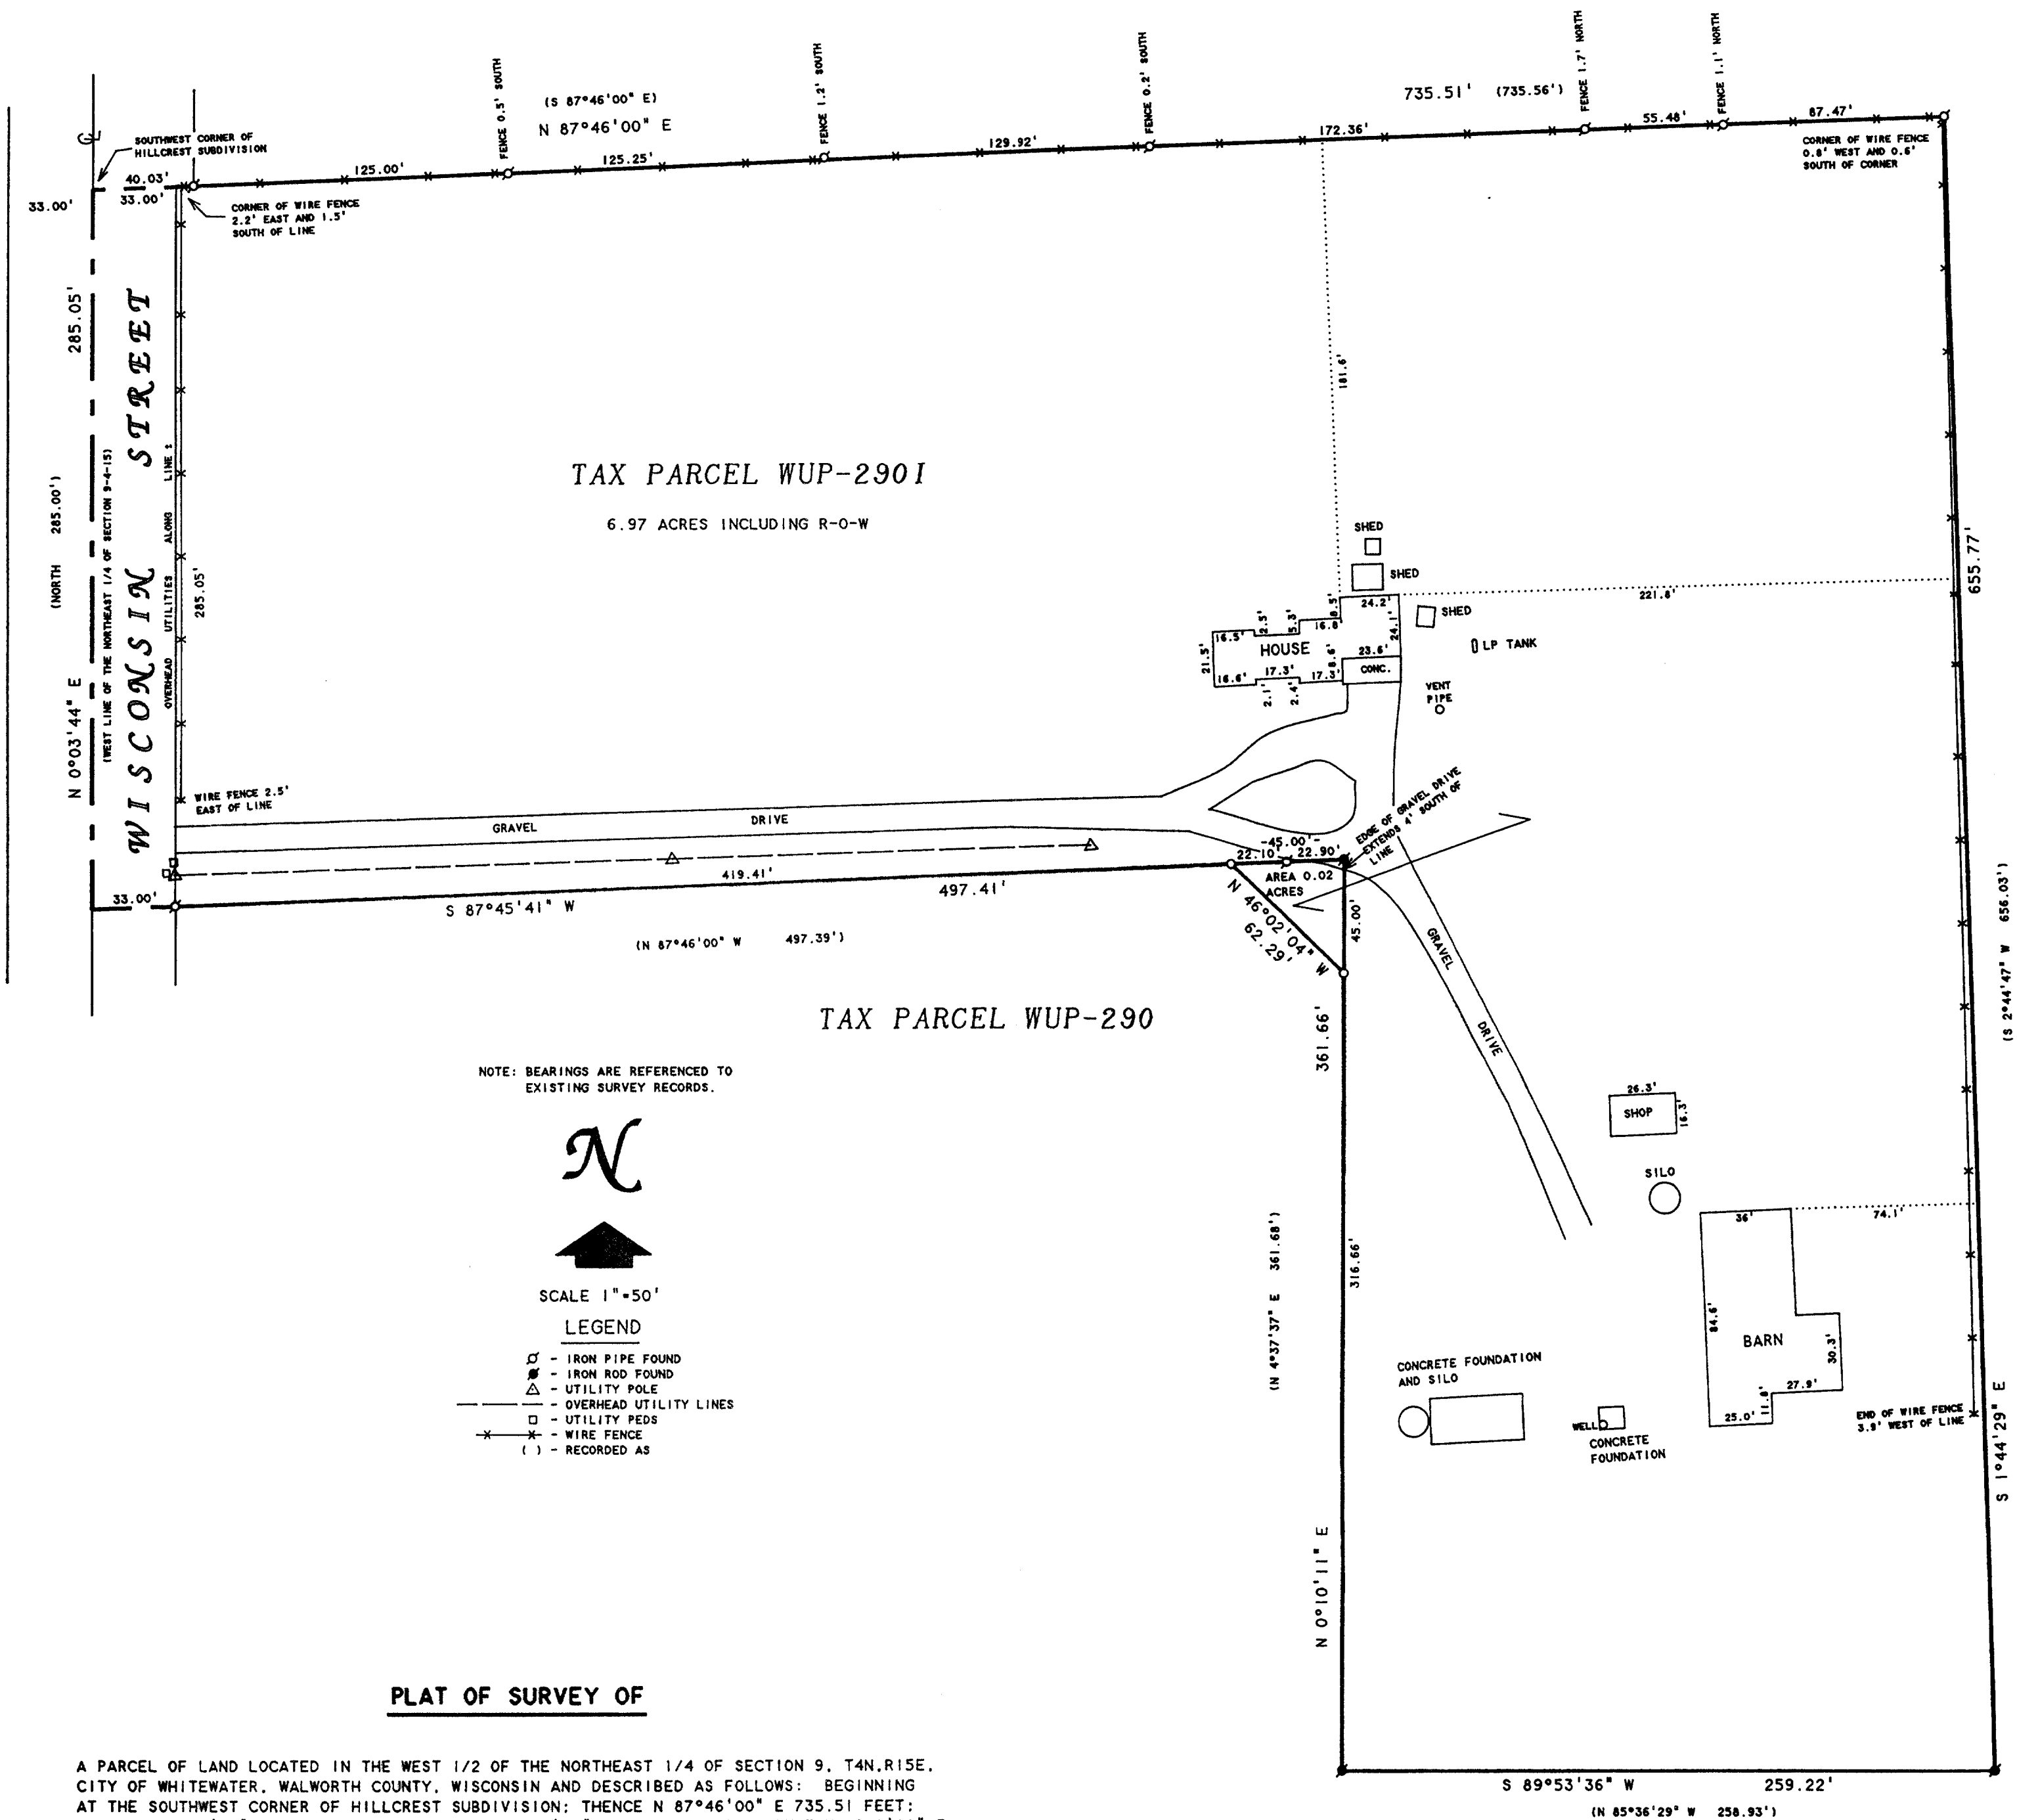

A PARCEL OF LAND LOCATED IN THE WEST 1/2 OF THE NORTHEAST 1/4 OF SECTION 9, T4N,R15E, CITY OF WHITEWATER, WALWORTH COUNTY, WISCONSIN AND DESCRIBED AS FOLLOWS: BEGINNING AT THE SOUTHWEST CORNER OF HILLCREST SUBDIVISION; THENCE N 87°46'00" E 735.51 FEET; THENCE S 1°44'29" E 655.77 FEET; THENCE S 89°53'36" W 259.22 FEET; THENCE N 0°10'11" E 361.66 FEET; THENCE S 87°45'41" W 497.41 FEET TO THE WEST LINE OF SAID NORTHEAST 1/4 OF SAID SECTION 9; THENCE N 0°03'44" E 285.05 FEET ALONG SAID WEST LINE TO THE SOUTHWEST CORNER OF HILLCREST SUBDIVISION AND THE PLACE OF BEGINNING, CONTAINING 6.97 ACRES OF LAND.

THE ABOVE DESCRIBED PROPERTY PREVIOUSLY DESCRIBED IN VOLUME 18, PAGE 45 AS DOCUMENT NO. 618769 AND IN VOLUME 328, PAGE 48 AS DOCUMENT NUMBER 105449, WALWORTH COUNTY RECORDS.

TOGETHER WITH:

A PROPOSED LOT LINE ADJUSTMENT OF A PARCEL OF LAND LOCATED IN THE WEST 1/2 OF THE NORTHEAST 1/4 OF SECTION 9, T4N,R15E, CITY OF WHITEWATER, WALWORTH COUNTY, WISCONSIN AND DESCRIBED AS FOLLOWS: COMMENCING AT THE SOUTHWEST CORNER OF HILLCREST SUBDIVISION; THENCE S 0°03'44" W ALONG THE WEST LINE OF SAID NORTHEAST 1/4, 285.05 FEET; THENCE N 87°45'41" E 452.41 FEET TO THE PLACE OF BEGINNING; THENCE CONTINUE N 87°45'41" E 45.00 FEET; THENCE S 0°10'11" W 45.00 FEET; THENCE N 46°02'04" W 62.29 FEET TO THE PLACE OF BEGINNING, CONTAINING 0.02 ACRES OF LAND MORE OR LESS.

THIS IS A LOT LINE ADJUSTMENT BETWEEN TAX PARCEL WUP-290 AND TAX PARCEL WUP-2901.

ORDERED BY: RE/MAX-LAKES AREA REALTORS  
1815 N. SHORE DRIVE  
DELAVAN, WI. 53115

REVISED DATE: SEPTEMBER 4, 2002  
REVISED TO SHOW PROPOSED LOT LINE  
ADJUSTMENT.

ORDERED BY: BRIAN CEBERTOWICZ  
601 S. WISCONSIN STREET  
WHITEWATER, WI 53190


I HEREBY CERTIFY THAT I HAVE SURVEYED THE ABOVE DESCRIBED PROPERTY AND THAT THE ABOVE MAP IS A TRUE REPRESENTATION THEREOF AND SHOWS THE SIZE AND LOCATION OF THE PROPERTY, ITS EXTERIOR BOUNDARIES, THE LOCATION OF ALL VISIBLE STRUCTURES AND DIMENSIONS OF ALL PRINCIPAL BUILDINGS THEREON, BOUNDARY FENCES, APPARENT EASEMENTS, ROADWAYS AND VISIBLE ENCROACHMENTS, IF ANY, TO THE BEST OF MY KNOWLEDGE AND BELIEF.

THIS SURVEY IS MADE FOR THE USE OF THE PRESENT OWNERS OF THE PROPERTY, AND ALSO THOSE WHO PURCHASE, MORTGAGE, OR GUARANTEE THE TITLE THERETO WITHIN ONE (1) YEAR FROM DATE HEREON.

DAVID F. ABELL  
WISCONSIN REGISTERED LAND SURVEYOR, S-1596

July 16, 2001  
DATE  
NOTE: THIS IS NOT A CERTIFIED COPY UNLESS SEALED.

JOB NUMBER - 01094A

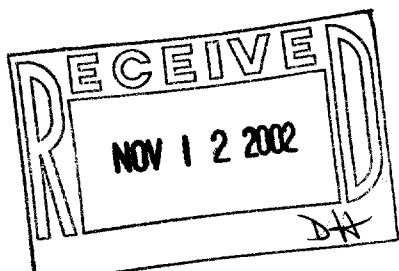

WUP-2901

010-678