

Plat of Survey

of


Lands described in a Warranty Deed recorded in Vol. 648 on Page 4350 as Document No. 359362 as shown below:

PARCEL 1: A part of Lot 5 in Block 10 of City of Whitewater, bounded as follows: Beginning at NW corner of said Lot 5 and running thence South on West line of said Lot 72.4 feet to a stake, thence East at right angles to said West line 61 feet to a stake and on same course to East line of said lot, thence North on East line of said lot to NE corner of said lot, thence West on North line of said lot to place of beginning.



PARCEL 2: A part of Lot five (5) of Block ten (10) in the Village, now City, of Whitewater according to the Recorded plat thereof described as follows: Beginning at the Northwest corner of said lot and running thence South on the West line of said lot 72.4 ft. to a stake which is the point of beginning of this description; thence East at right angles to said West line 61.0 ft. to a stake and on the same course to the East line of said lot; thence South on said East line 6.00 ft. to a point; thence West on a line at right angles to the West line of said lot to a point on the West line of said lot; thence North on the West line of said lot 6.00 ft. to the place of beginning.

Surveyed for: **Olm & Associates**

522 West Main Street ** P.O. Box 37
Whitewater, Wisconsin. 53121.

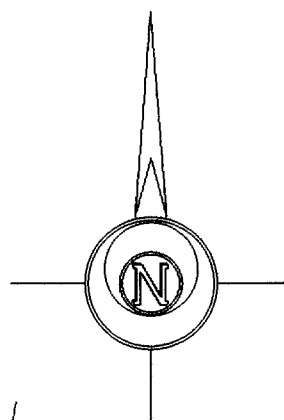

Bearings reference to previous surveys of record.

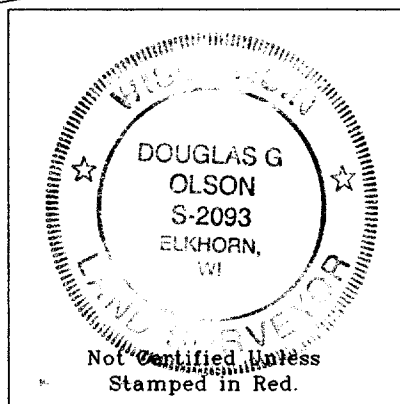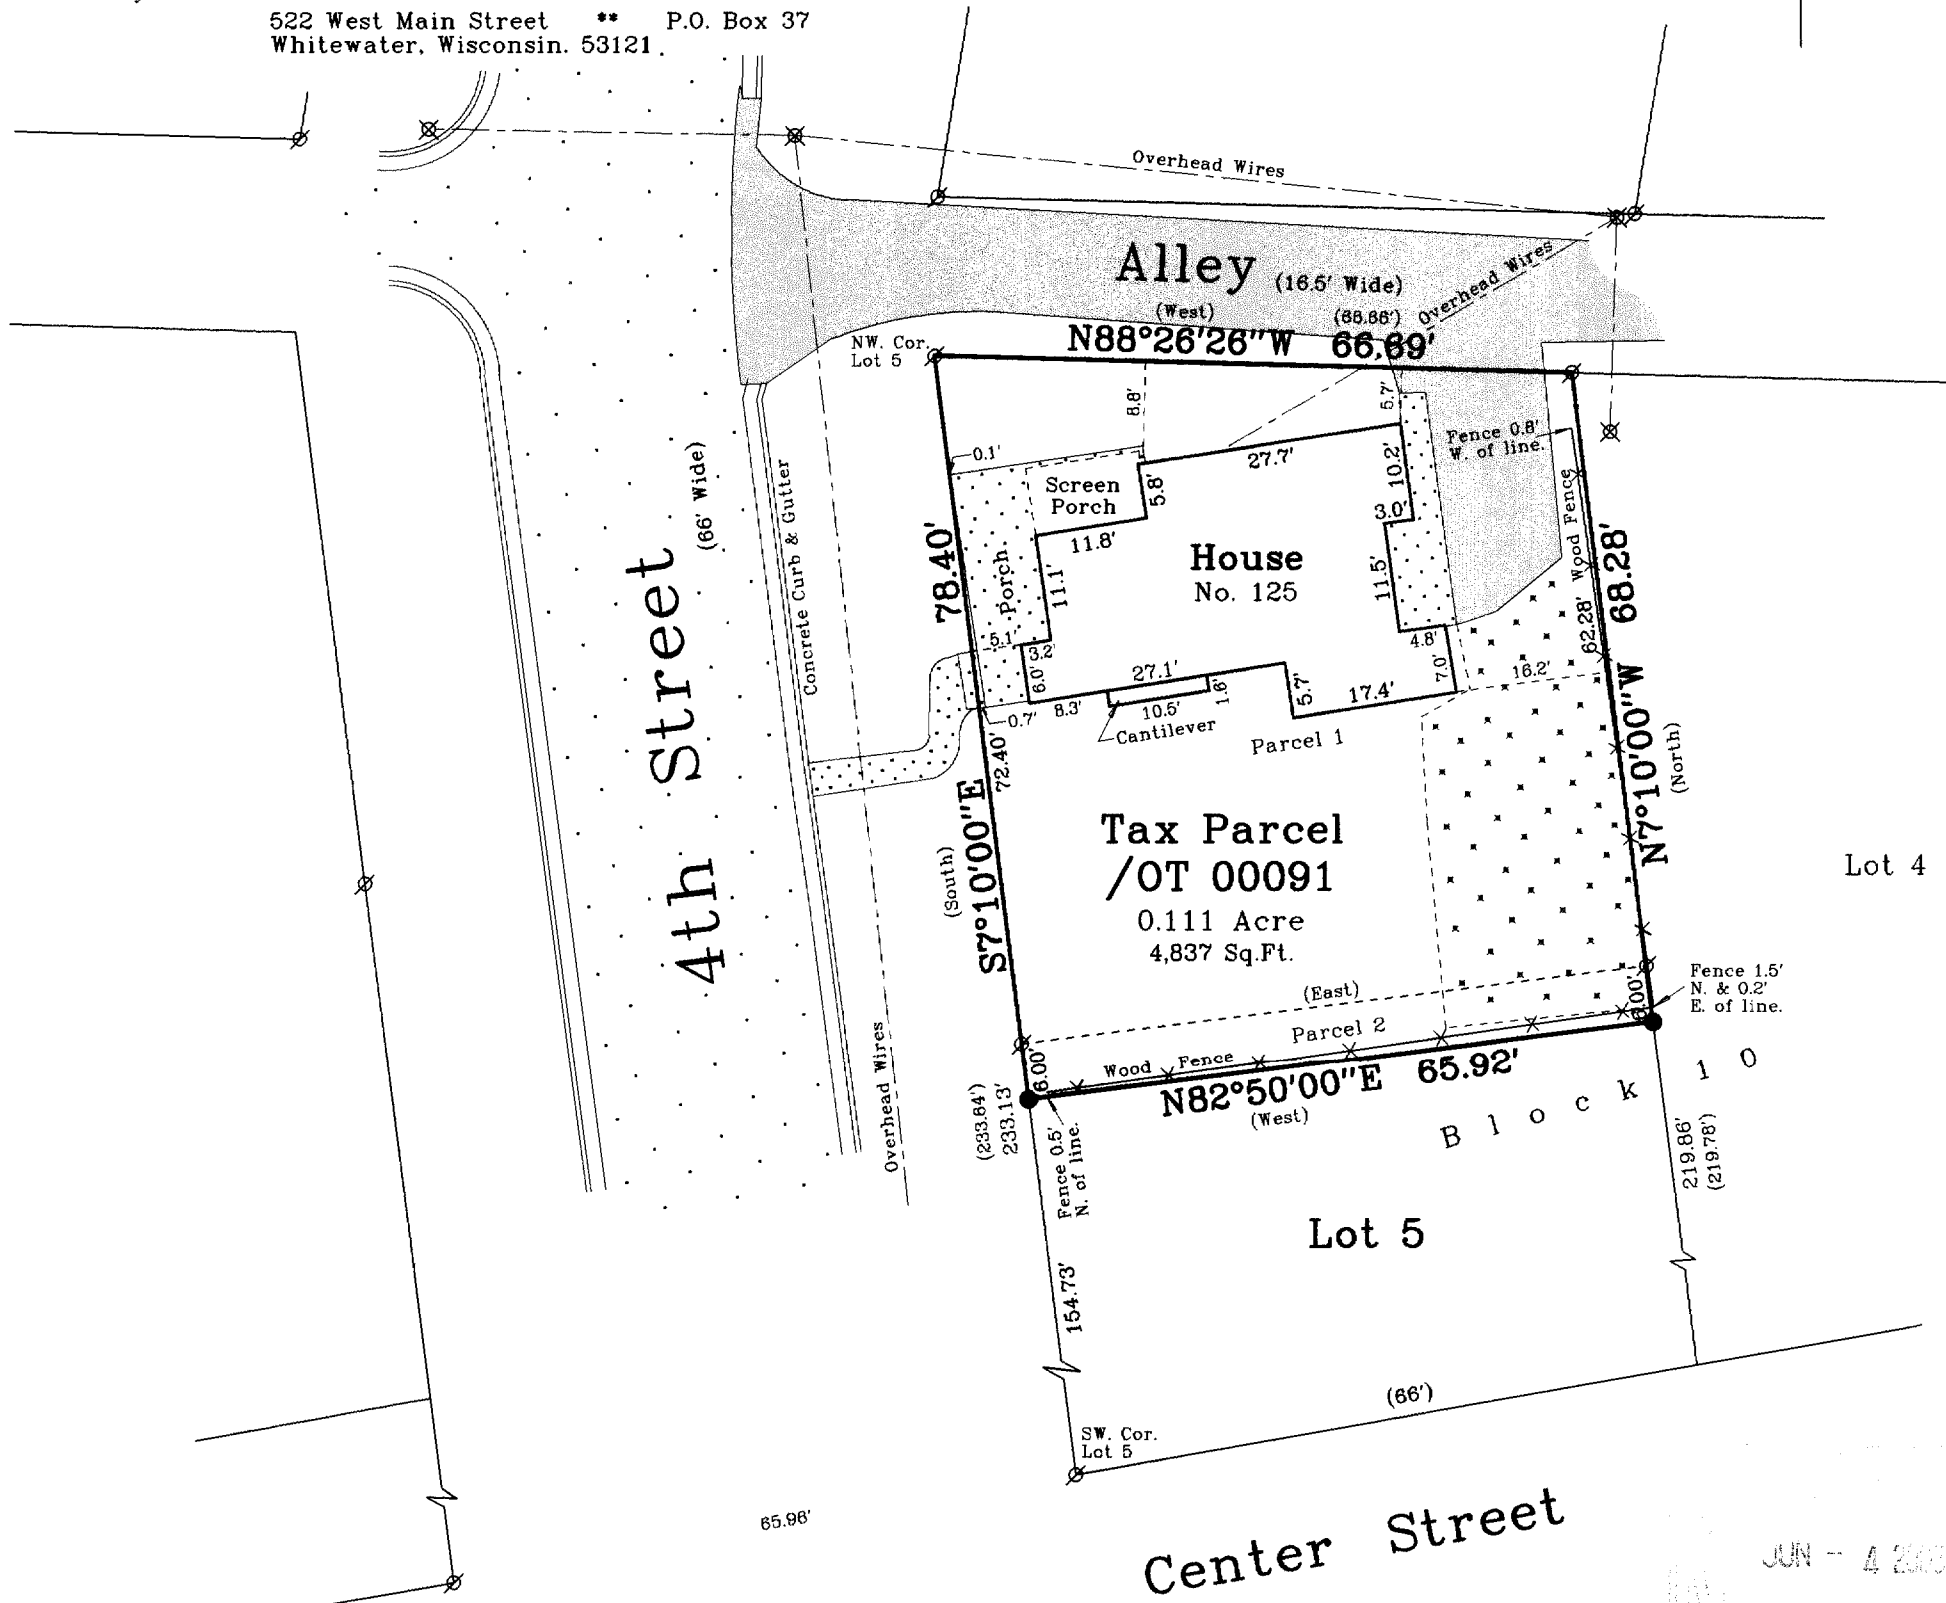

Copyright c 2002 by Jensen & Olson Land Surveying, LLC.

All rights reserved. No part of this survey plat may be reproduced or transmitted in any form by any means - graphic, electronic, or mechanical, including photocopying, tracing, or information storage and retrieval systems - without permission in writing from Douglas G. Olson, Jensen & Olson Land Surveying, LLC.

I hereby certify that I have surveyed the above described property and the map hereon is correct to the best of my professional knowledge and belief and shows the size and location of the property, its exterior boundaries, the location and dimensions of all visible structures thereon, boundary fences, apparent easements and roadways and visible encroachments, if any.

This survey is made for the exclusive use of the present owners of property, and also those who purchase, mortgage or guarantee title thereto, within one year from the date hereof.

Douglas G. Olson
Wisconsin Registered Land Surveyor - 2093

Notes: 1) This survey plat is not certified unless signed and sealed in red ink.

2) This survey is subject to Wisconsin lien laws. This Plat of Survey is the notice of intent to file lien. Lien waiver required.

Legend

- Found Iron Pipe
- Set Iron Rod, 3/4" dia.
- () Recorded Information
- ✕ Utility Pole
- ▨ Concrete Surface
- ▨ Asphalt Surface
- ▨ Gravel Surface

Jensen & Olson Land Surveying, LLC

45 South Wisconsin Street P.O. Box 322
Elkhorn, Wisconsin. 53121
Telephone: (262) 723-3434
Facsimile: (262) 723-8044

Scale: 1" = 20'



Survey date: August 13, 2002.

Revisions:

Sheet 1 of 1 Sheets.

Job Reference Number:

010-694 2002.139

10T-91