

# Plat of Survey

of



Lands described in a Warranty Deed recorded on September 14, 2001 as Document No. 483029 as shown below:

The North forty-four (44) feet of Lot Nineteen (19) and the South thirty-eight (38) feet of Lot Twenty (20) in Block Two (2), Fish and Johnson's Addition to the City of Whitewater, Walworth County, Wisconsin.

ALSO

A part of Lot numbered Sixteen (16) in Bulkley & Tratts Addition to the City of Whitewater, as follows: Commencing at the Southwest corner of Lot numbered Nineteen (19), Block numbered Two (2), of Fish and Johnson's Addition to the City of Whitewater; thence North along the West Line of said Lot Nineteen (19) for a distance of Twenty-two (22) Feet to the point of beginning; thence West Twenty-five (25) Feet to a point; thence North and parallel to the West Line of said Block Two (2) to the South Line of Lot Fifteen (15) of Bulkley & Tratts Addition to said City; thence East Twenty-five (25) Feet to a point; thence South along the West Line of said Block Two (2) to the point of beginning.

Surveyed for: **Olm & Associates**  
522 West Main Street \*\* P.O. Box 327  
Whitewater, Wisconsin. 53190

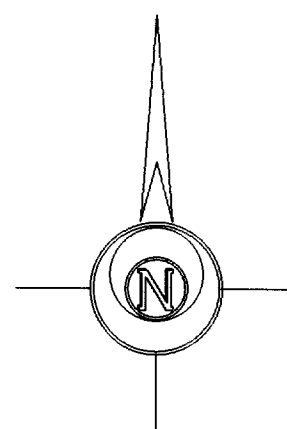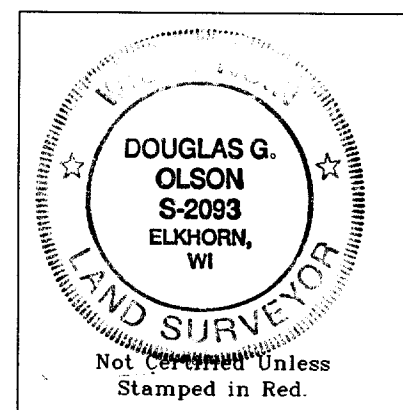

Bearings reference to previous surveys of record.

**Lot 16**  
**Bulkley & Tratts**  
**Addition**

## Notes:


- 1) This survey plat is not certified unless signed and sealed in red ink.
- 2) This survey is subject to Wisconsin lien laws. This Plat of Survey is the notice of intent to file lien. Lien waiver required.

Copyright © 2003 by Jensen & Olson Land Surveying, LLC.

All rights reserved. No part of this survey plat may be reproduced or transmitted in any form by any means - graphic, electronic, or mechanical, including photocopying, tracing, or information storage and retrieval systems - without permission in writing from Douglas G. Olson, Jensen & Olson Land Surveying, LLC.

I hereby certify that I have surveyed the above described property and the map hereon is correct to the best of my professional knowledge and belief and shows the size and location of the property, its exterior boundaries, the location and dimensions of all visible structures thereon, boundary fences, apparent easements and roadways and visible encroachments, if any.  
This survey is made for the exclusive use of the present owners of property, and also those who purchase, mortgage or guarantee title thereto, within one year from the date hereof.

Douglas G. Olson  
Wisconsin Registered Land Surveyor - 2093

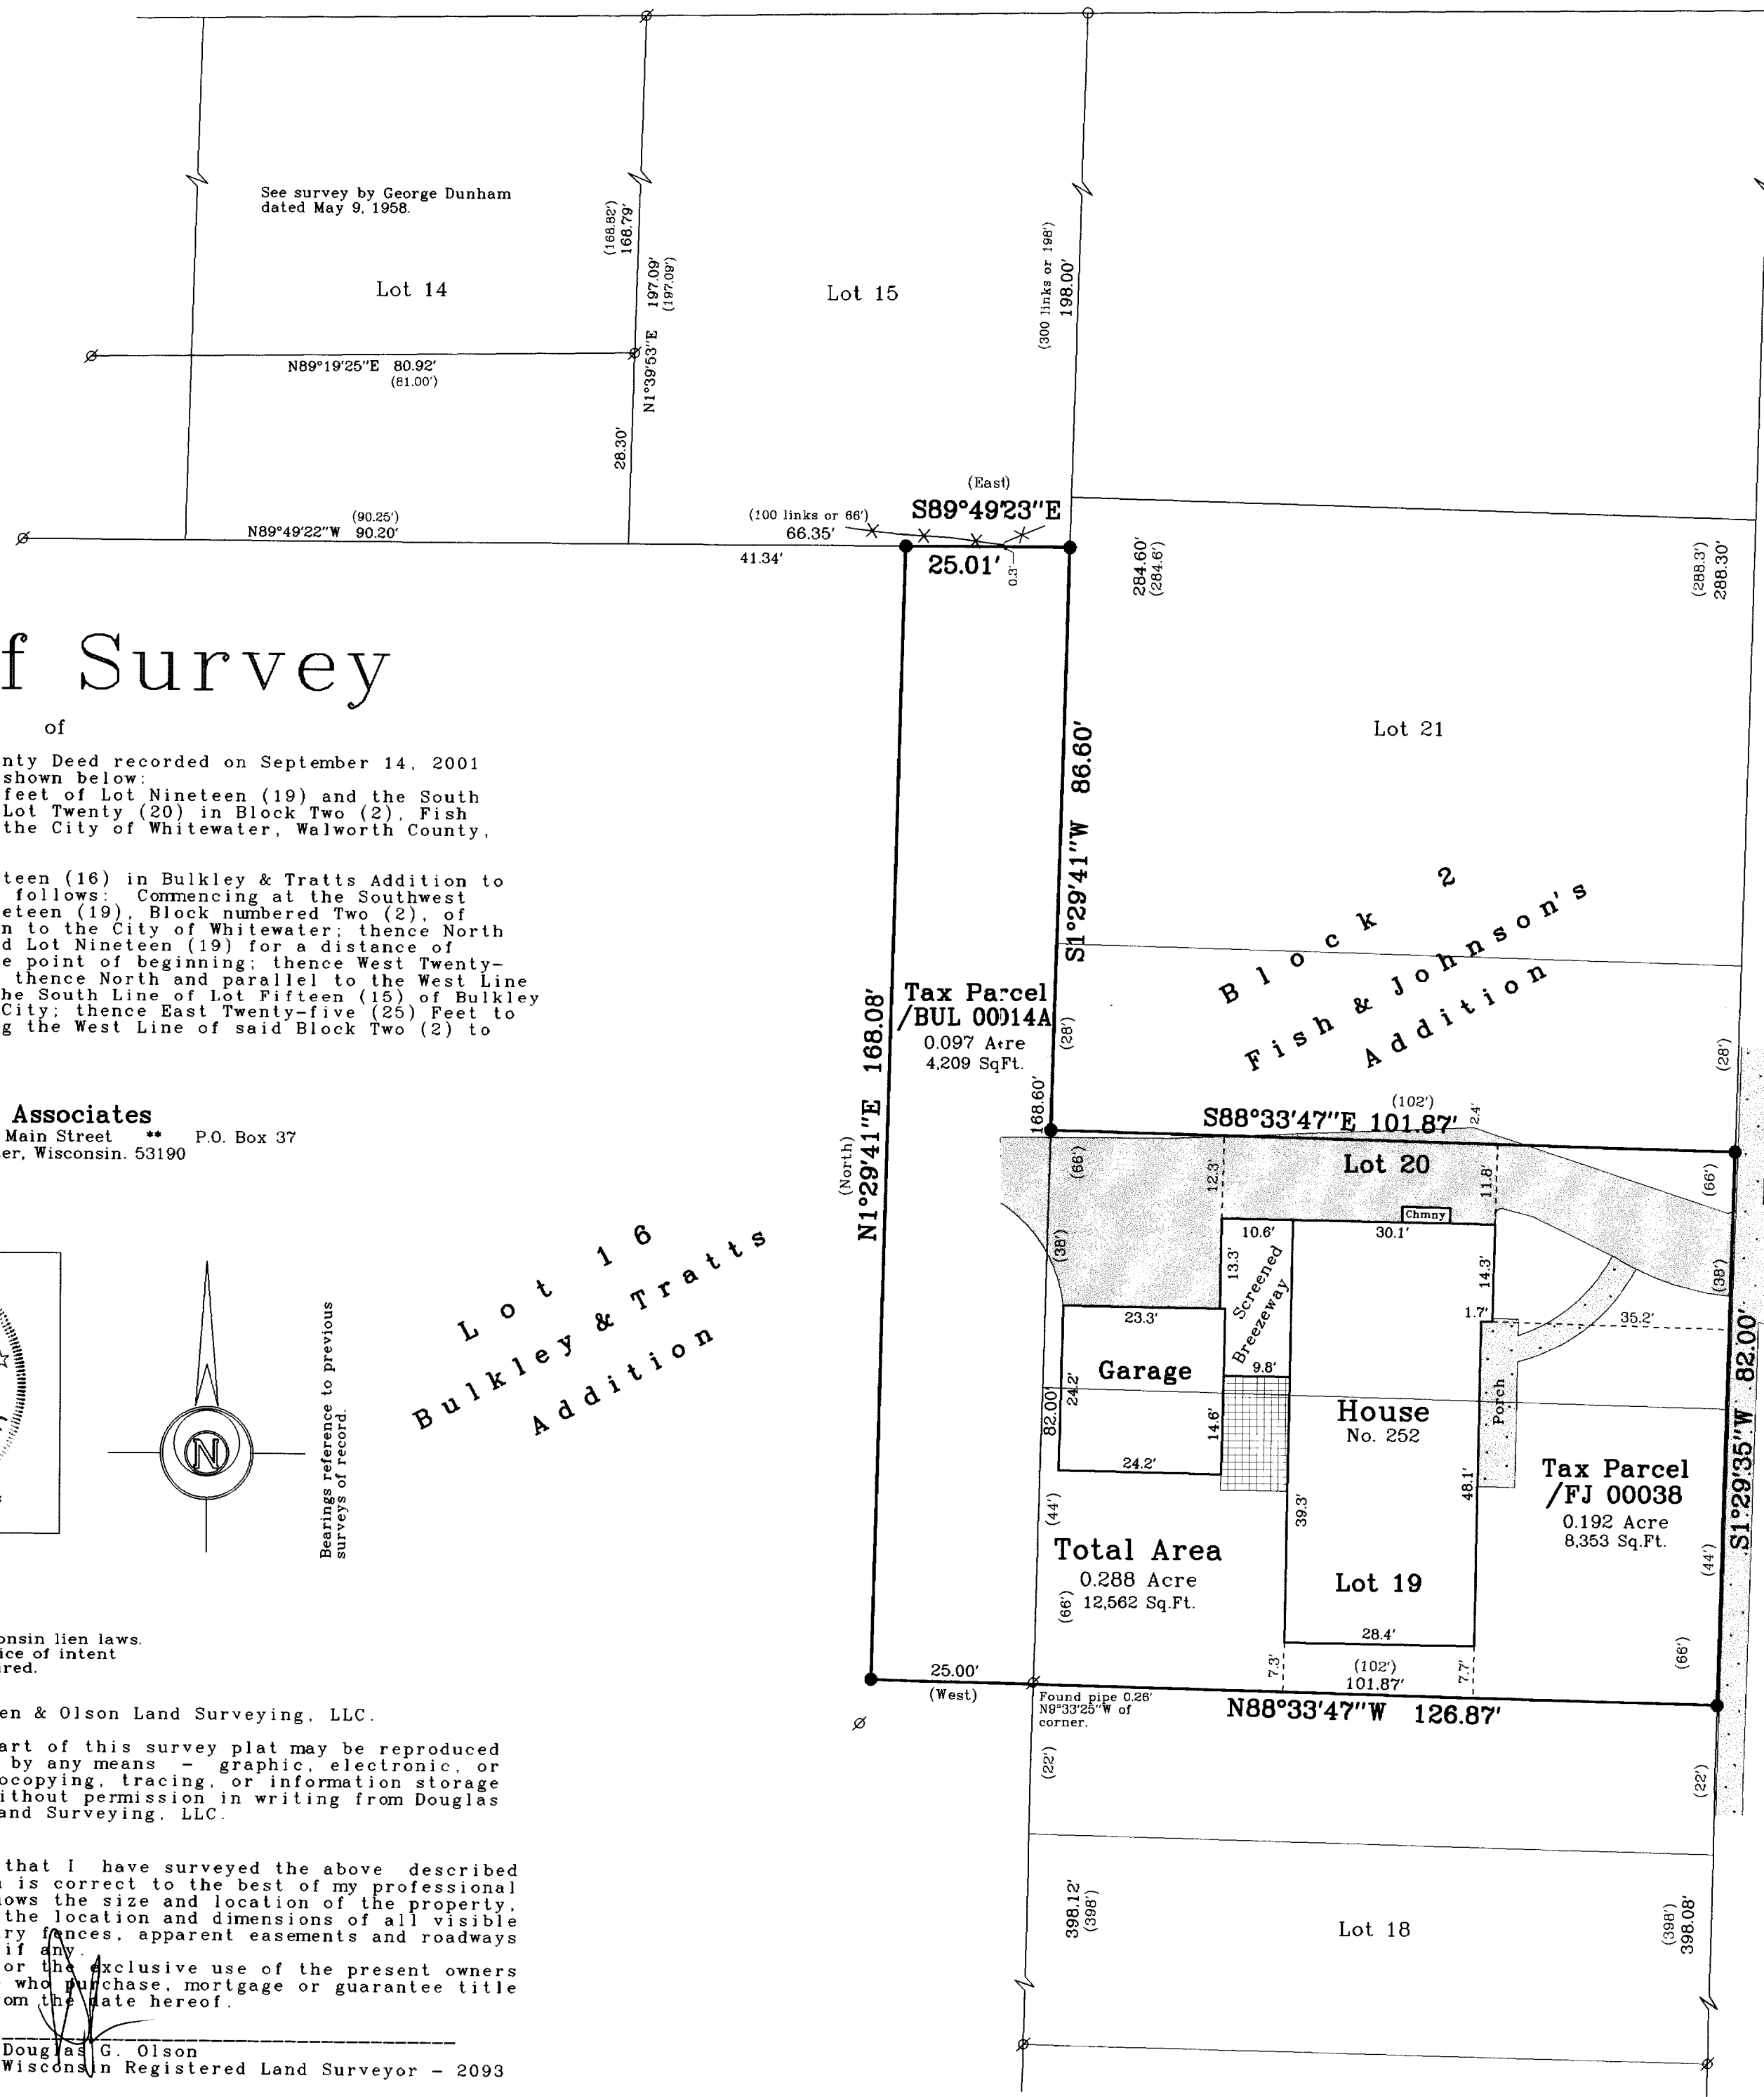

BUL-14A  
FJ-38

JAN 30

KW

Survey Date: November 7, 2003.  
Revisions:

Scale in Feet  
1" = 20'  
0' 10' 20' 40'

**Jensen & Olson Land Surveying, LLC**

45 South Wisconsin Street P.O. Box 322  
Elkhorn, Wisconsin. 53121  
Telephone (262) 723-3434  
Facsimile (262) 723-8044

**Legend**  
Found Concrete Monument  
Found Iron Pipe  
Found Iron Rod  
Set Iron Rod, 3/4" dia.  
Recorded Information  
Concrete Surface  
Asphalt Surface  
Brick Patio

Sheet 1 of 1 Sheets

Job Reference Number

2003.183

2003.183

010-703