PLAT OF SURVEY

Part of Lot Five (5) in Block Eleven (11) of S.C. Hall's Addition to the Village, now City of Whitewater, Walworth County, Wisconsin, and bounded as follows.

Commencing at the South line of Milwaukee Street at a point One Hundred Twelve (112) feet East from the center of a ditch; running thence West on the South line of said Milwaukee Street to the center of a ditch; thence South along the center of the ditch two (2) chains and Fifteen (15) links to the South line of said lot; thence South Eighty-five (85) degrees East along the South line of the lot to a point directly South of the place of beginning; thence North parallel to the center of said ditch to Milwaukee Street and the place of beginning.

Surveyed for: Greg Greenwood

Survey address: 953 E. Milwaukee Street




- FOUND 1' IRON PIPE
- F.G.G. FOUND CHISELED CUT
- SET 1' IRON PIPE
- () RECORDED AS DIMENSIONS

"I hereby certify that I have surveyed the above described property and that the above map is a true representation thereof and shows the size and location of the property, its exterior boundaries, the location of all visible structures and dimension of all principal buildings thereon, boundary fences, apparent easements, roadways and encroachments if any."

"This survey is made for the use of the present owners of the property, and also those who purchase, mortgage or guarantee the title thereto within one year from date hereof."

 12/10/04
 TEP/DW

 DATE
 FIELD WORK BY

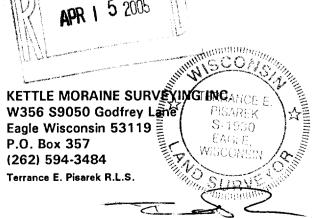

THIS IS NOT AN ORIGINAL SURVEY UNLESS THE SEAL IS RED.

TEP 04217

DRAWN BY JOB NUMBER

1HAS

OB-725