


PLAT OF SURVEY
LOTS 69 AND 80, WESTPARK SECOND ADDITION, located in the Southwest $\frac{1}{4}$ of Section 5, Town 4 North, Range 15 East, City of Whitewater, Walworth County, Wisconsin.

2005

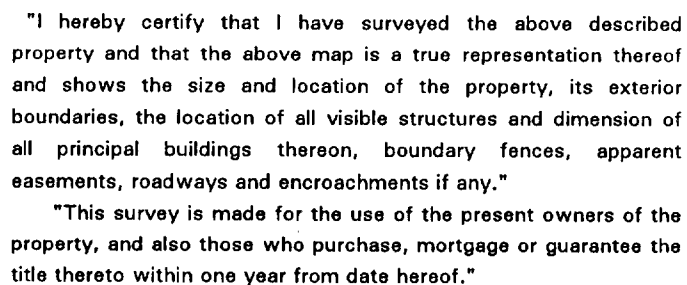

G INC.

DATE: 4/27/05 FIELD WORK BY: TEP DRAWN BY: TEP JOB NUMBER: 05064

610-752