LAND-MARK SURVEYING

Mark L. Miritz

Wisconsin Registered Land Surveyor S-2582

ORDERED BY: DENNIS STANTON TINCHER REALTY 532 WEST MAIN STREET WHITEWATER, WI 53190


N9330 Knuteson Drive Whitewater, WI 53190 Phone:(262)495-3284 FAX: (262) 495-8421 LAND-MARKSURVEYING.COM

PLAT OF SURVEY

THE EAST HALF (E 1/2) OF LOT 4, BLOCK 4, BIRGE'S ADDITION TO THE CITY OF WHITE-WATER, WALWORTH COUNTY, WISCONSIN.



PECK STREET

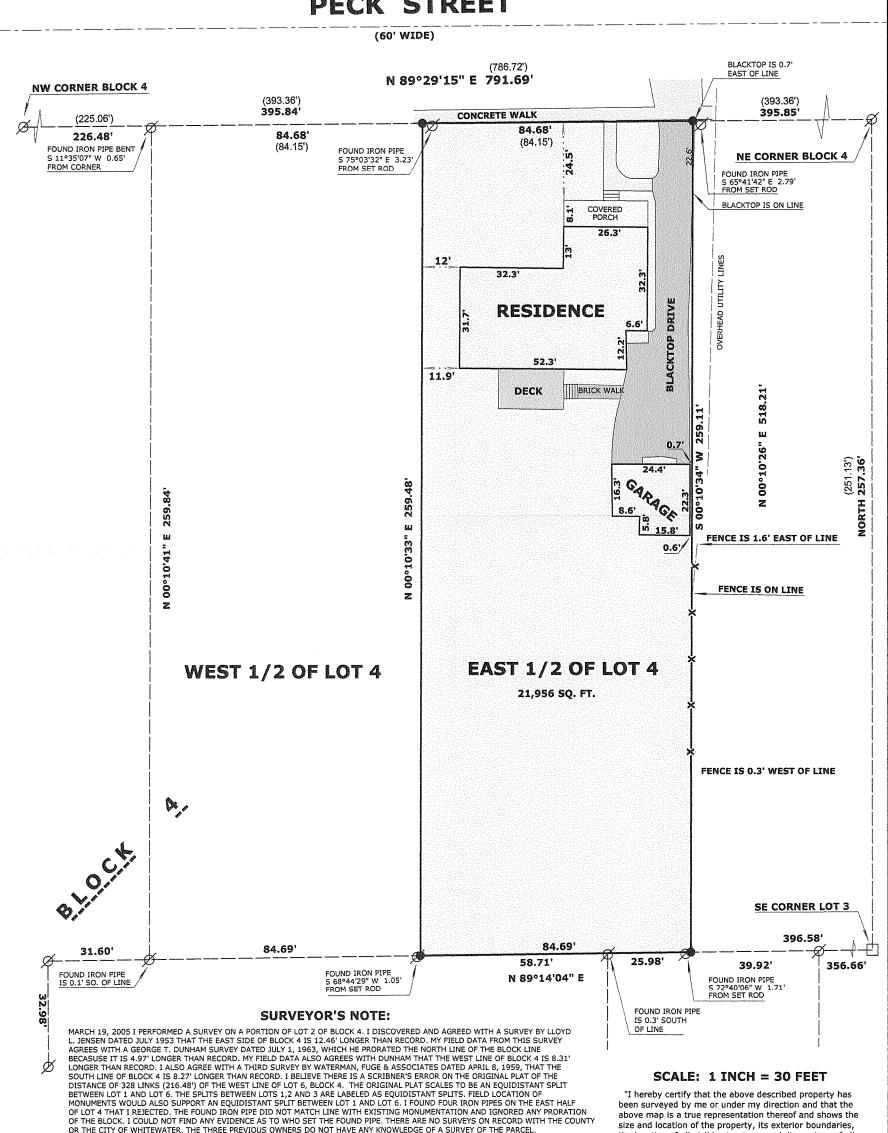

WECONS!

MARK L

MIRITZ

S-2582

WHITEWATER,

WI

10

Station of the second SUR

LEGEND

Ø FOUND IRON PIPE

FOUND RECTANGLE BAR

SET IRON ROD, 24" LONG, WEIGHING 1.5 LBS./LINEAL FT., 3/4" DIA.

OR THE CITY OF WHITEWATER. THE THREE PREVIOUS OWNERS DO NOT HAVE ANY KNOWLEDGE OF A SURVEY OF THE PARCEL.

RECORDED AS DIMENSION (xx)

EXISTING FENCE

been surveyed by me or under my direction and that the above map is a true representation thereof and shows the size and location of the property, its exterior boundaries, the location of all visible structures and dimensions of all principal buildings thereon, boundary fences, apparent easements, roadways and visible encroachments, if any."

"This survey is made for the use of the present owners of guarantee the title thereto within one year from date hereof." the property, and also those who purchase, mortgage, or

MARK L. MIRITZ **WISCONSIN REGISTERED**

LAND SURVEYOR S-2582 MAY 17, 2009 JOB NO. 09.504 DATE:_