




SCALE-1"=20'
O=IRON PIPE

GARFIELD

PARKWAY

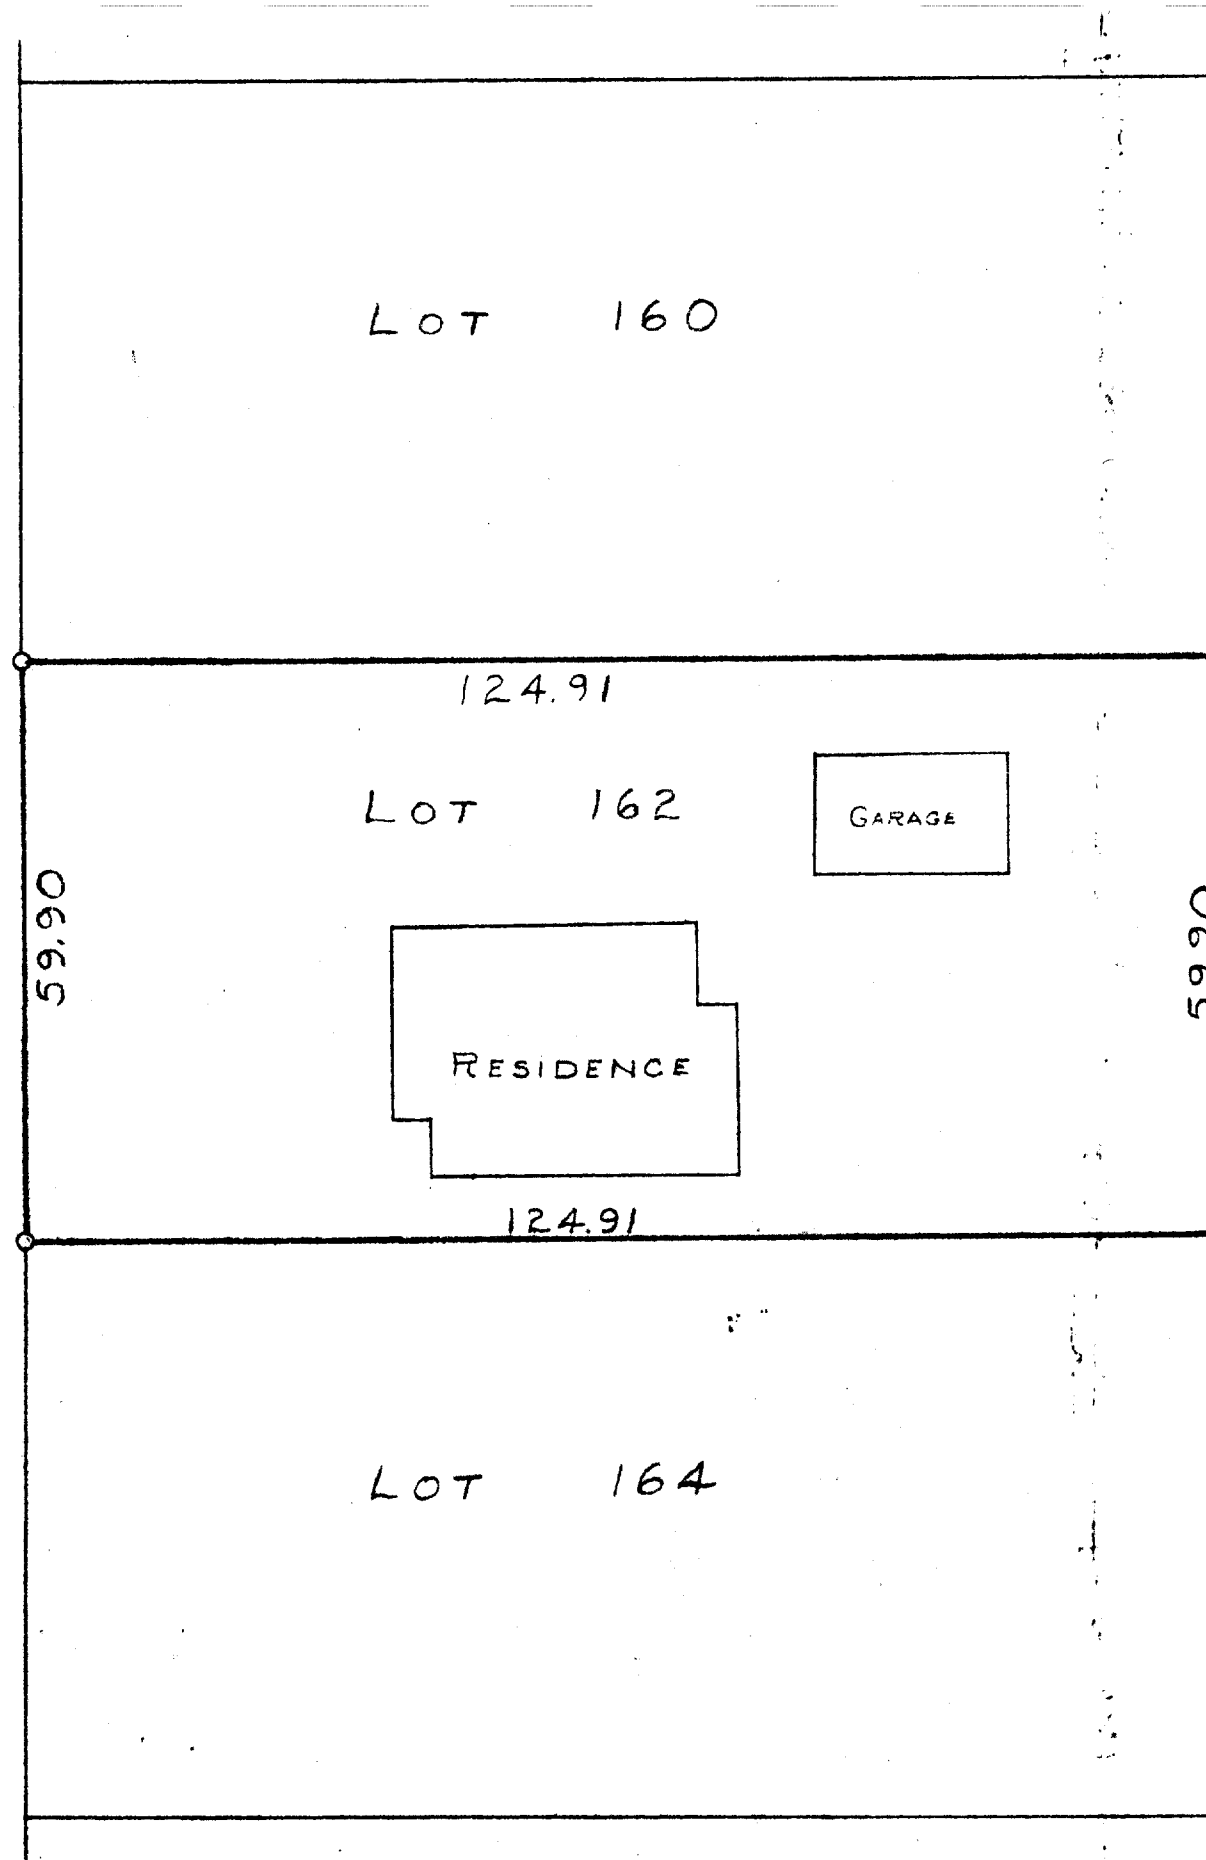

STATE OF WISCONSIN)
COUNTY OF WALWORTH)SS

I, GEORGE T. DUNHAM DO HEREBY CERTIFY THAT I HAVE SURVEYED
THE PROPERTY DESCRIBED AS FOLLOWS:

LOT 162 OF CEDAR POINT PARK LOCATED IN THE VILLAGE
OF WILLIAMS BAY, WALWORTH COUNTY, WISCONSIN

AND THAT THE PLAT SHOWN ABOVE IS A CORRECT REPRESENTATION
OF THE PROPERTY LINES

JUNE 20, 1953

11-1

George T. Dunham
GEORGE T. DUNHAM SURVEYOR
DELAVER, WISCONSIN

WCP-135